

rm A1-187
rch 1961

UNITED STATES
DEPARTMENT OF THE INTERIOR
BUREAU OF LAND MANAGEMENT


H-2847
62792

CTION

Oregon State Water Filings

NW 1/4 NW 1/4

TOWNSHIP 40S, RANGE 10E, W. M.

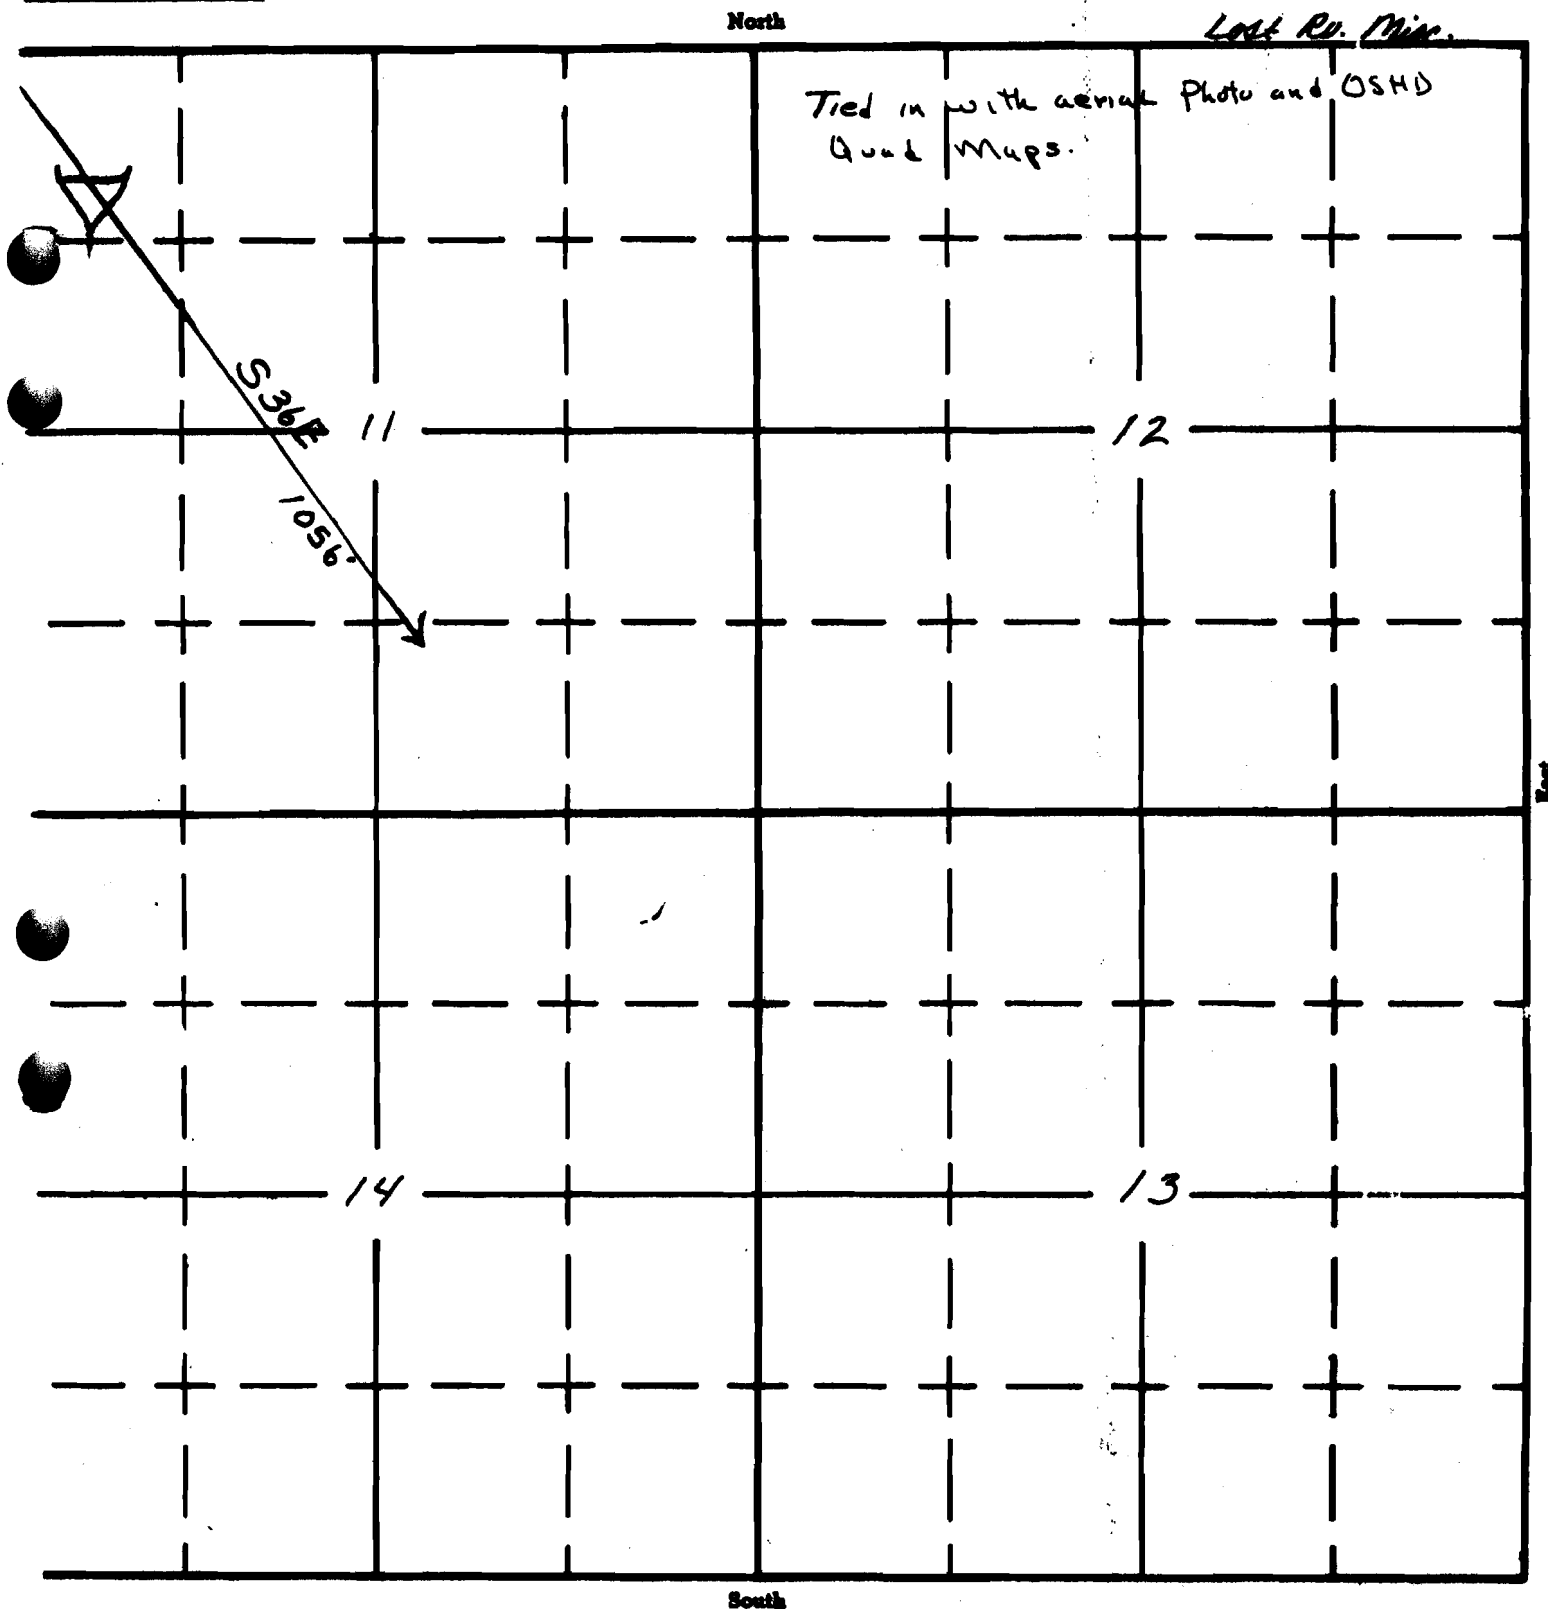

APPLICATION No. R-35140

DEVELOPED BY D. J. B. 1/7