

FM A1-187
rch 1961

UNITED STATES
DEPARTMENT OF THE INTERIOR
BUREAU OF LAND MANAGEMENT


R-2851
62794

SECTION
10

Oregon State Water Filings

SW 1/4 NE 1/4

TOWNSHIP 38 S, RANGE 11 E, W. M.

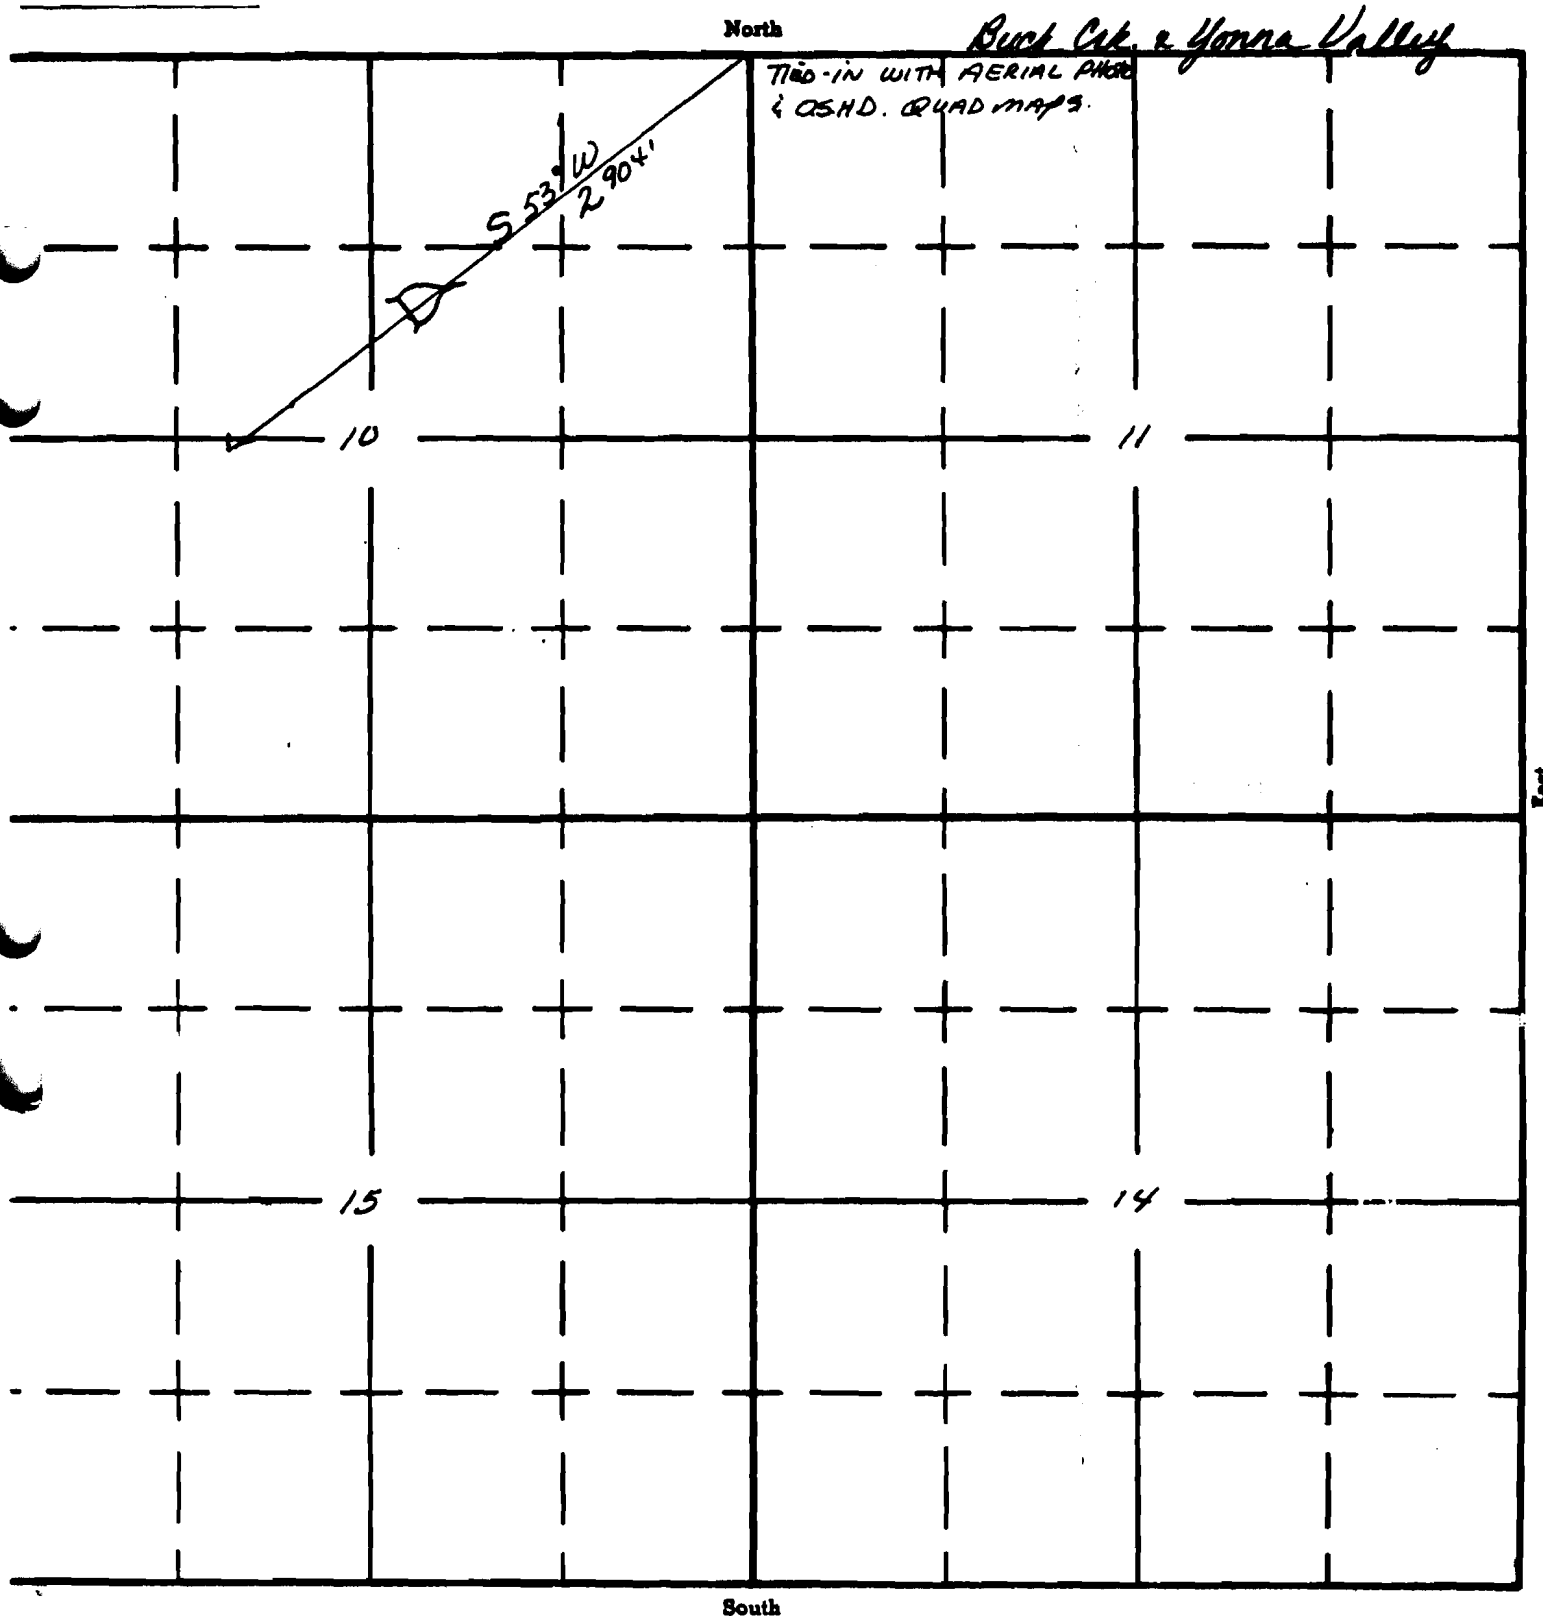

APPLICATION No. R-35151

DATE N. R. 2851