

UNITED STATES
DEPARTMENT OF THE INTERIOR
BUREAU OF LAND MANAGEMENT

SECTION


SW $\frac{1}{4}$ SW $\frac{1}{4}$

Sec. 18

Oregon State Water Filings

TOWNSHIP 24 S, RANGE 29 E, W. M.

North

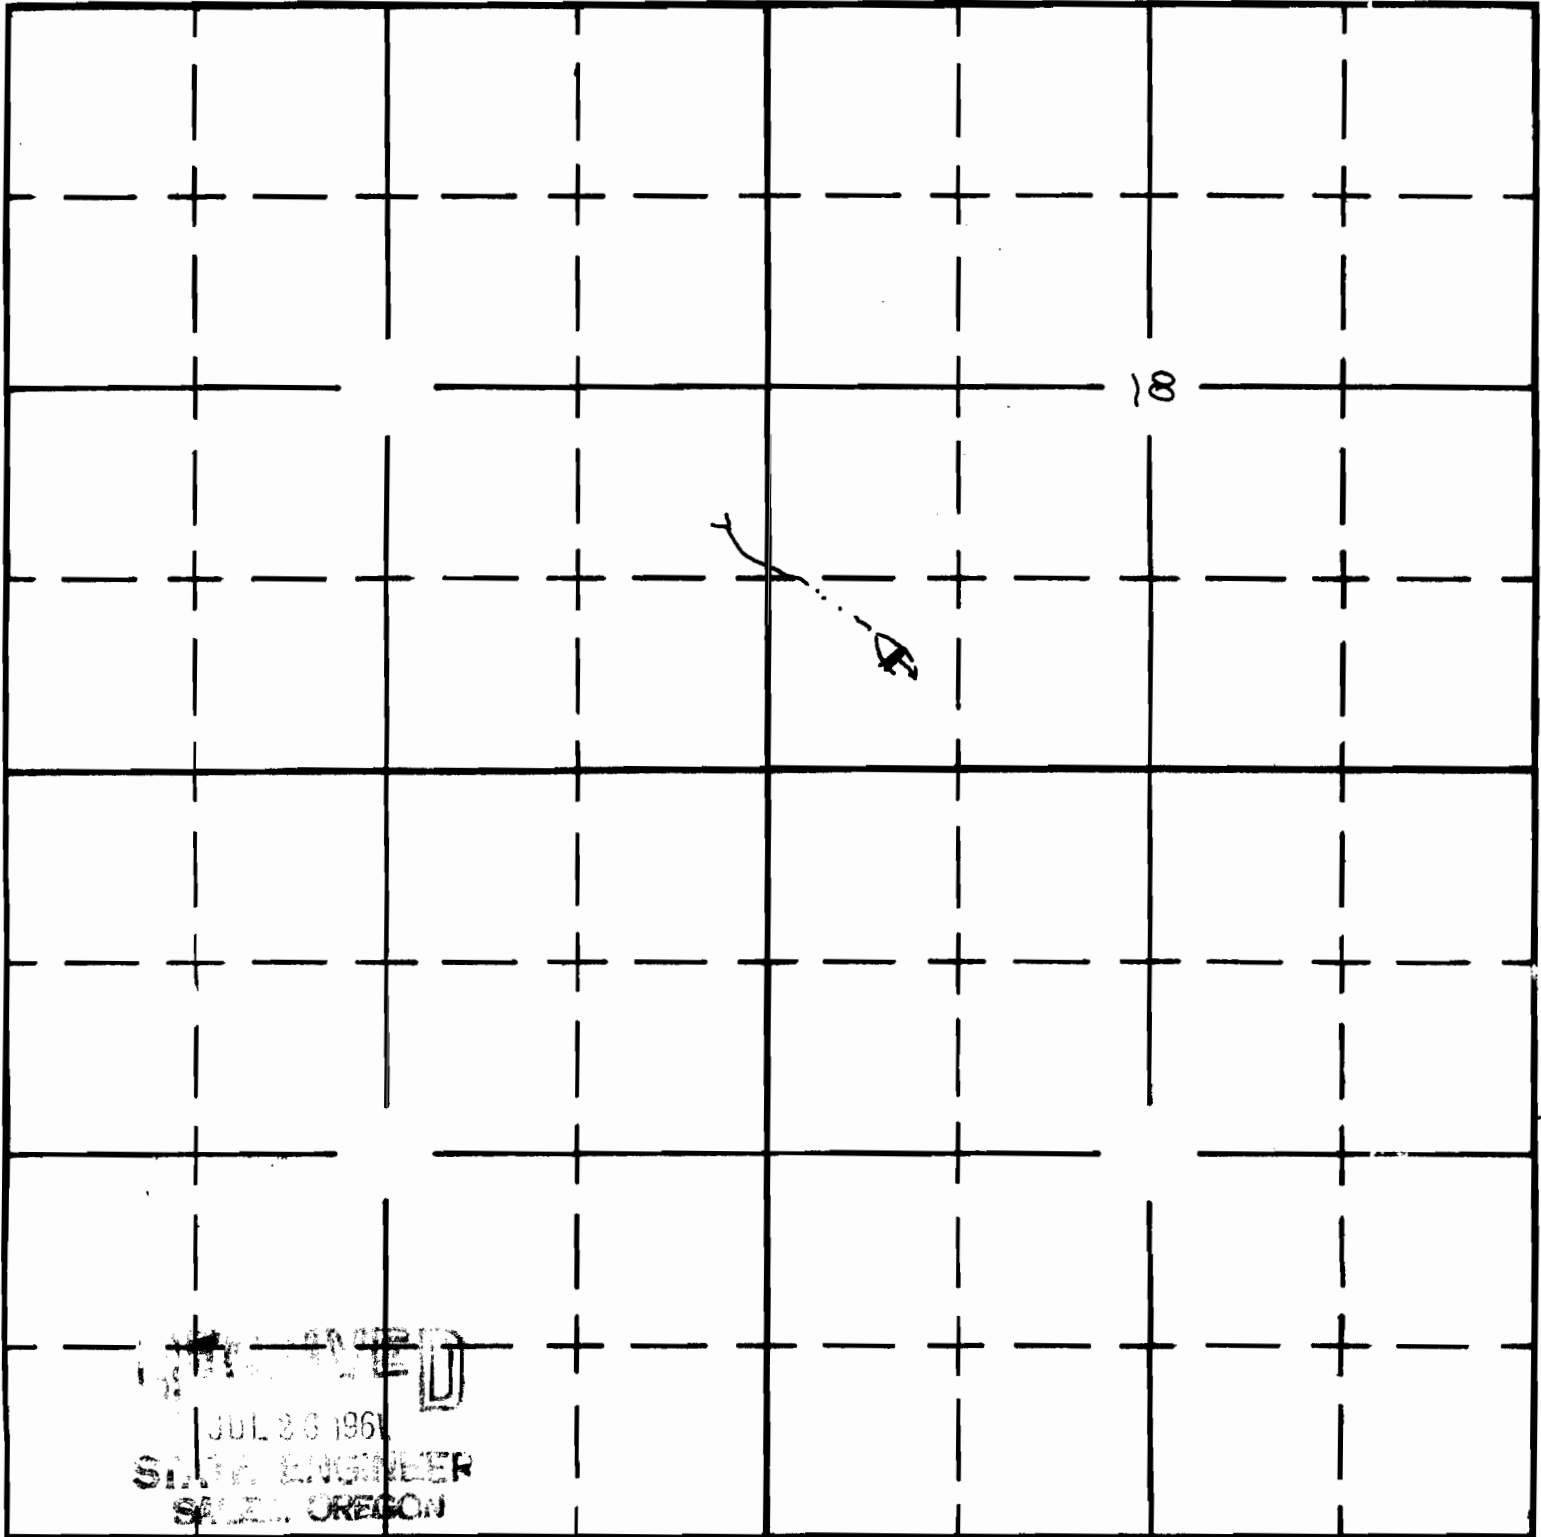

RECEIVED
JUL 20 1961
STATE ENGINEER
SALEM, OREGON

South

APPLICATION No. R-35540

PERMIT No. R-2883