

UNITED STATES
DEPARTMENT OF THE INTERIOR
BUREAU OF LAND MANAGEMENT

SECTION


NW 1/4 NW 1/4

Oregon State Water Filings

SEC. 1

TOWNSHIP 26 S, RANGE 23 E, W. M.

North

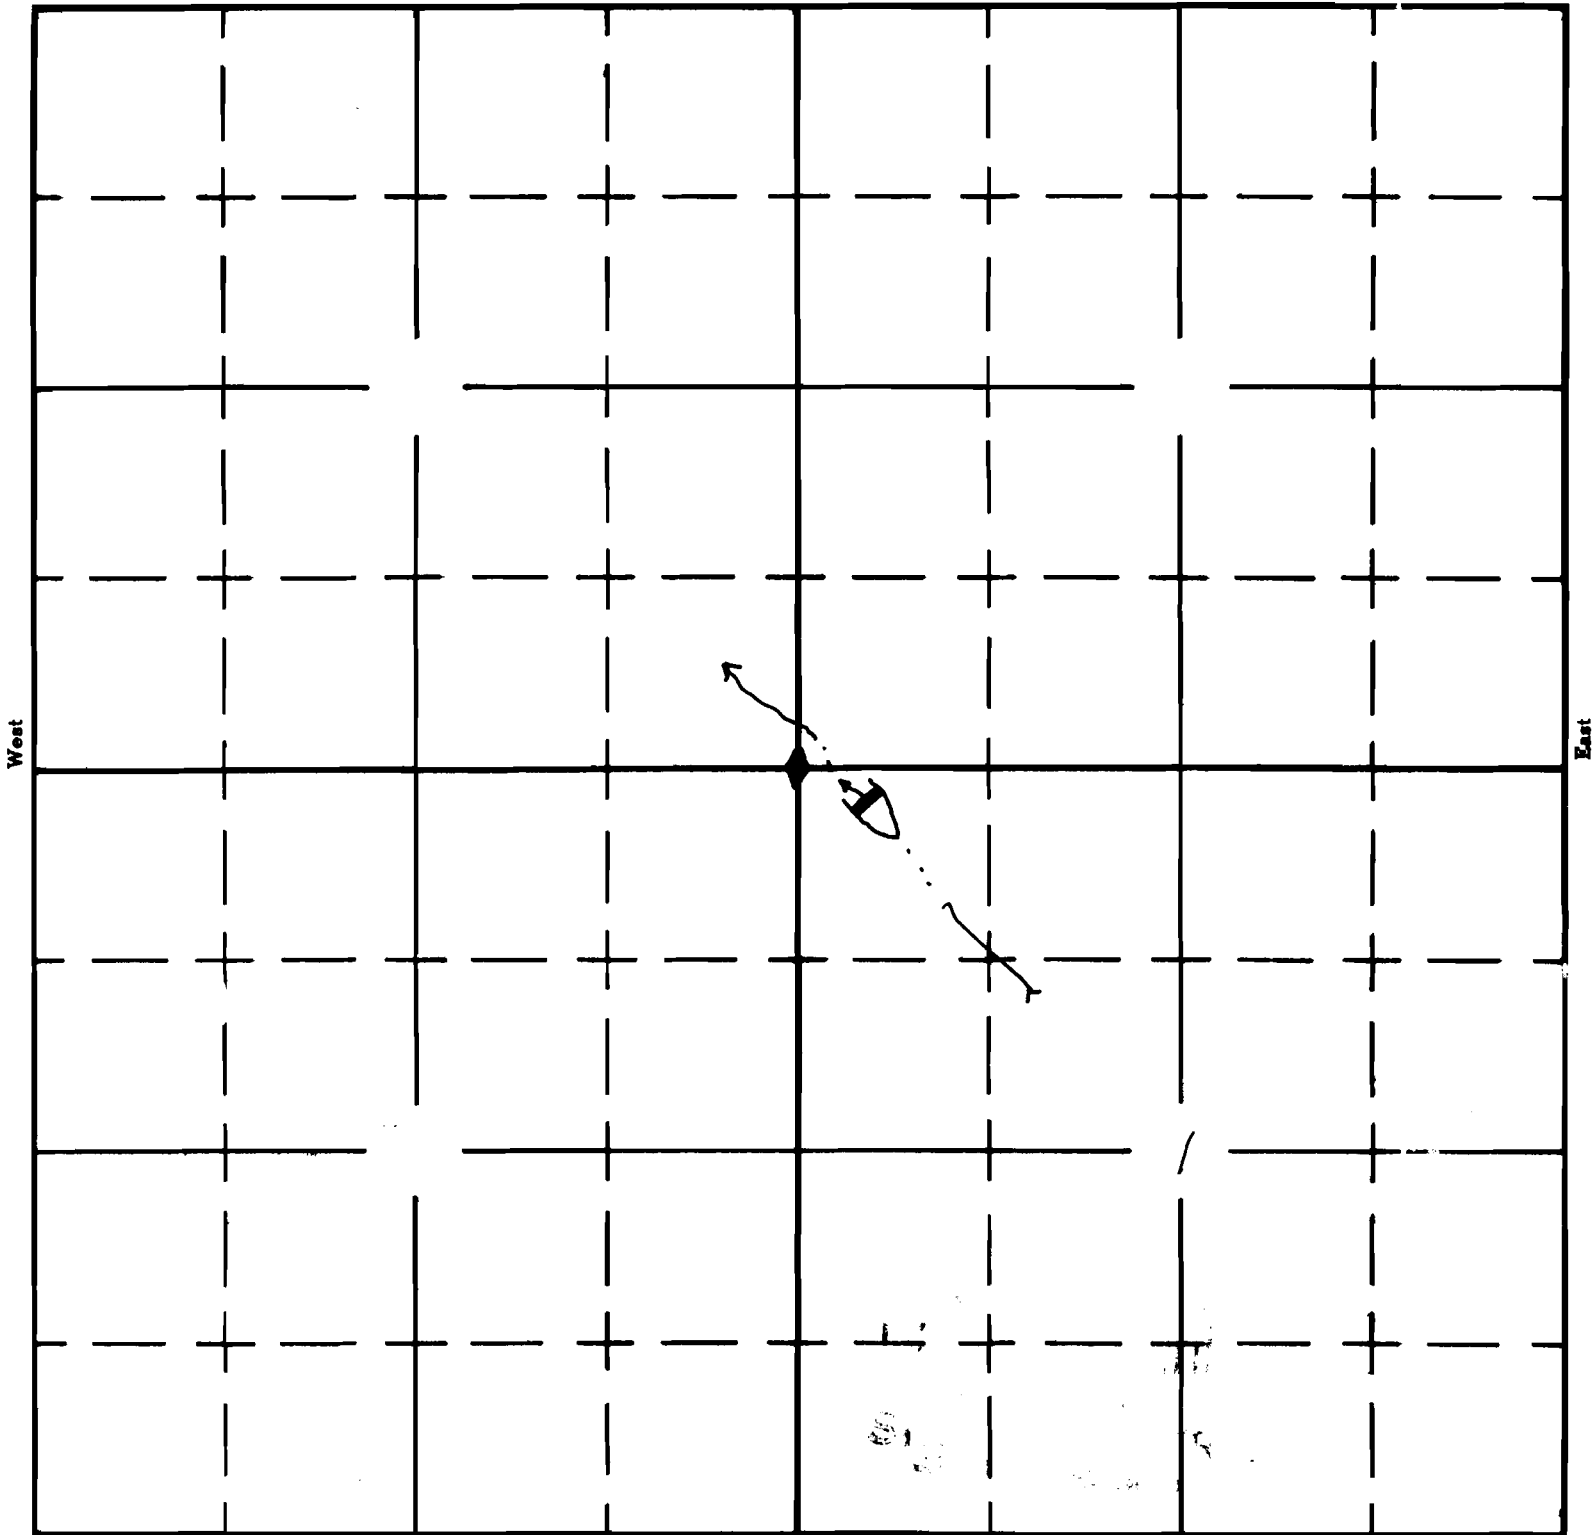

South

APPLICATION No. R-35570

PERMIT No. R-2911