

Form A1-187
March 1961

UNITED STATES
DEPARTMENT OF THE INTERIOR
BUREAU OF LAND MANAGEMENT


SECTION

35

Oregon State Water Filings

TOWNSHIP 39-S, RANGE 26-E, W. M.

North

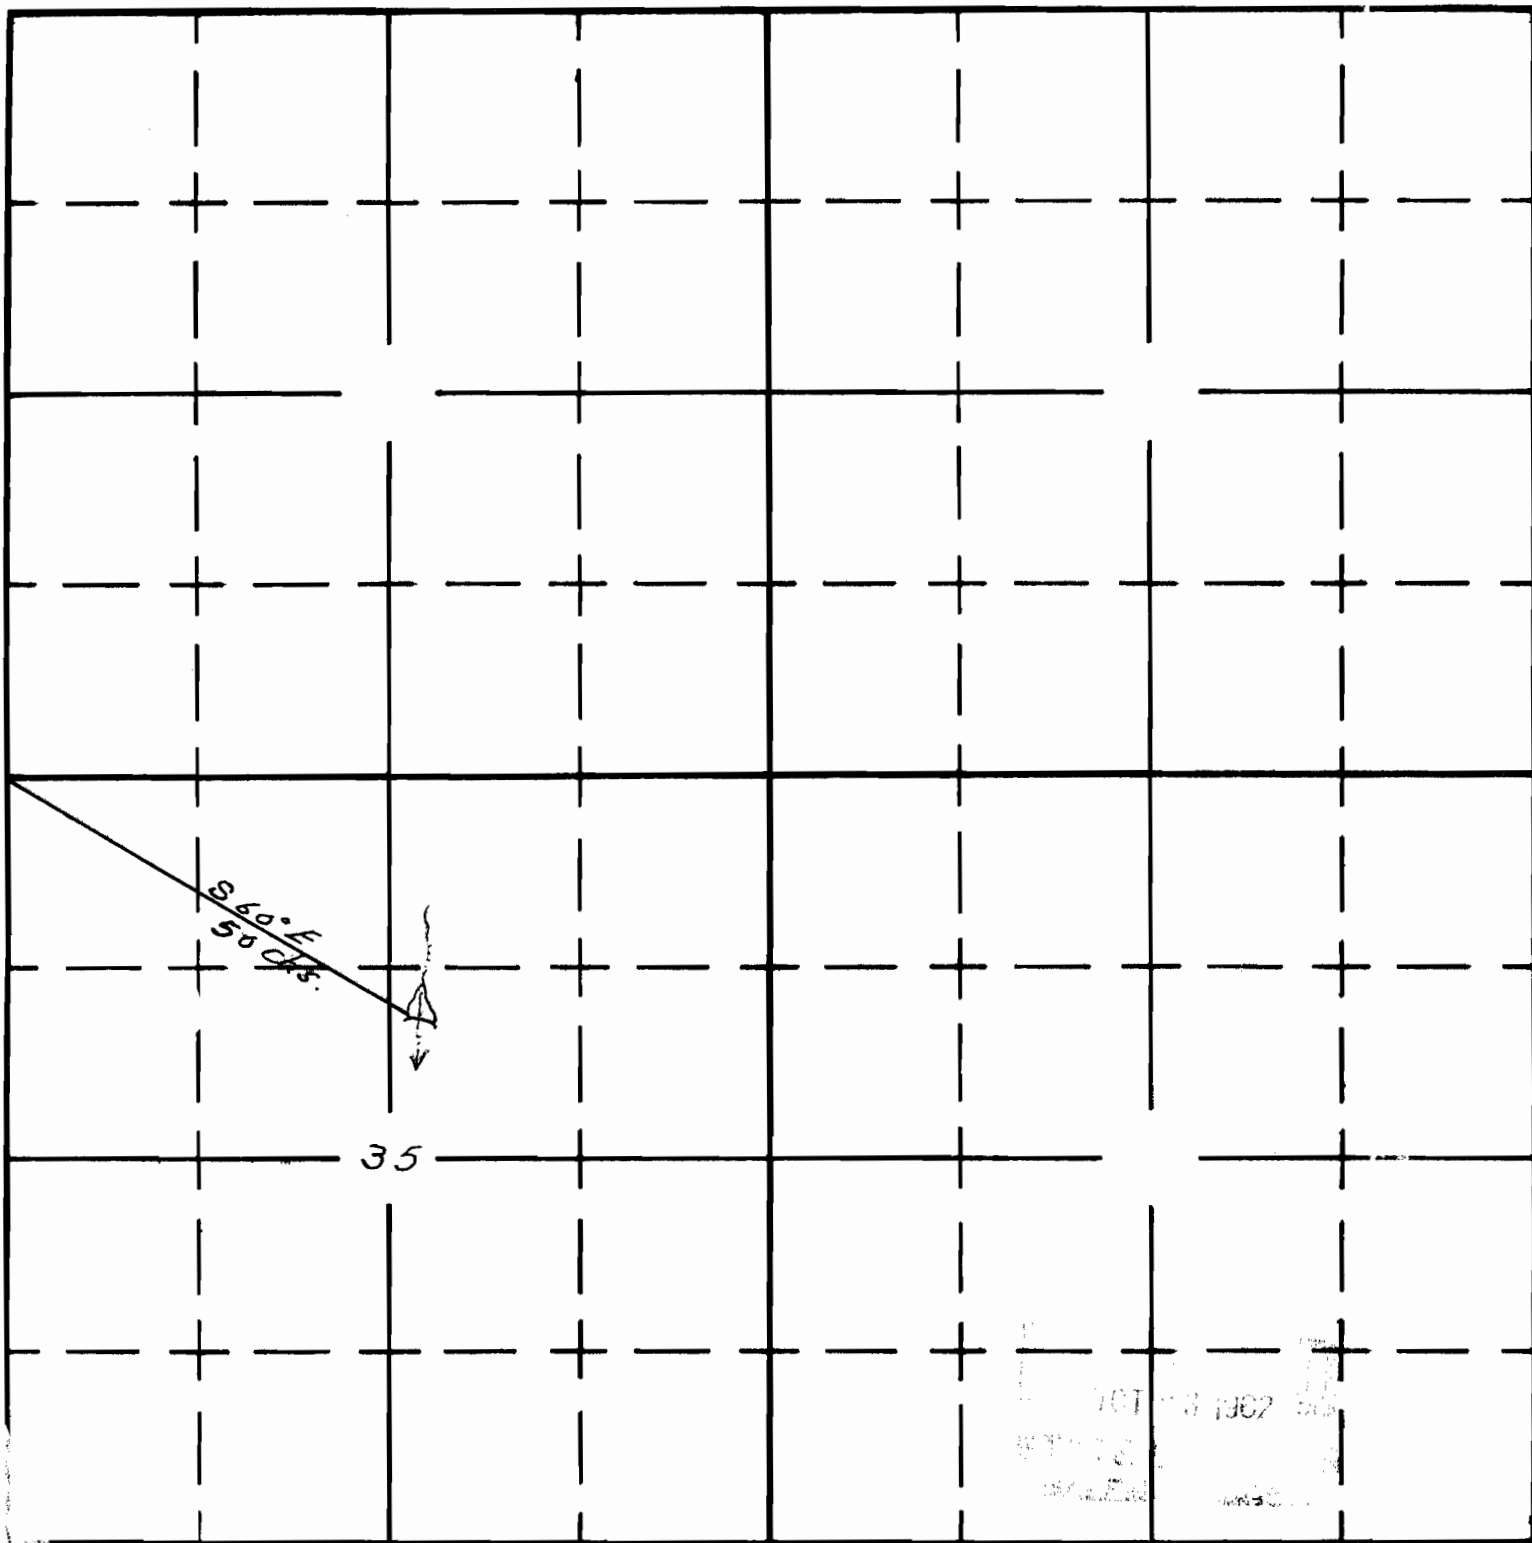

South

APPLICATION No. R-35167

PERMIT No. R-2966