

Form A1-187
March 1961

UNITED STATES
DEPARTMENT OF THE INTERIOR
BUREAU OF LAND MANAGEMENT


SECTION
NE SW Sec. 27

Oregon State Water Filings

TOWNSHIP 39S, RANGE 26E, W. M.

RECEIVED
SEP 8 1961
STATE ENGINEER
ALEX. OREGON

North

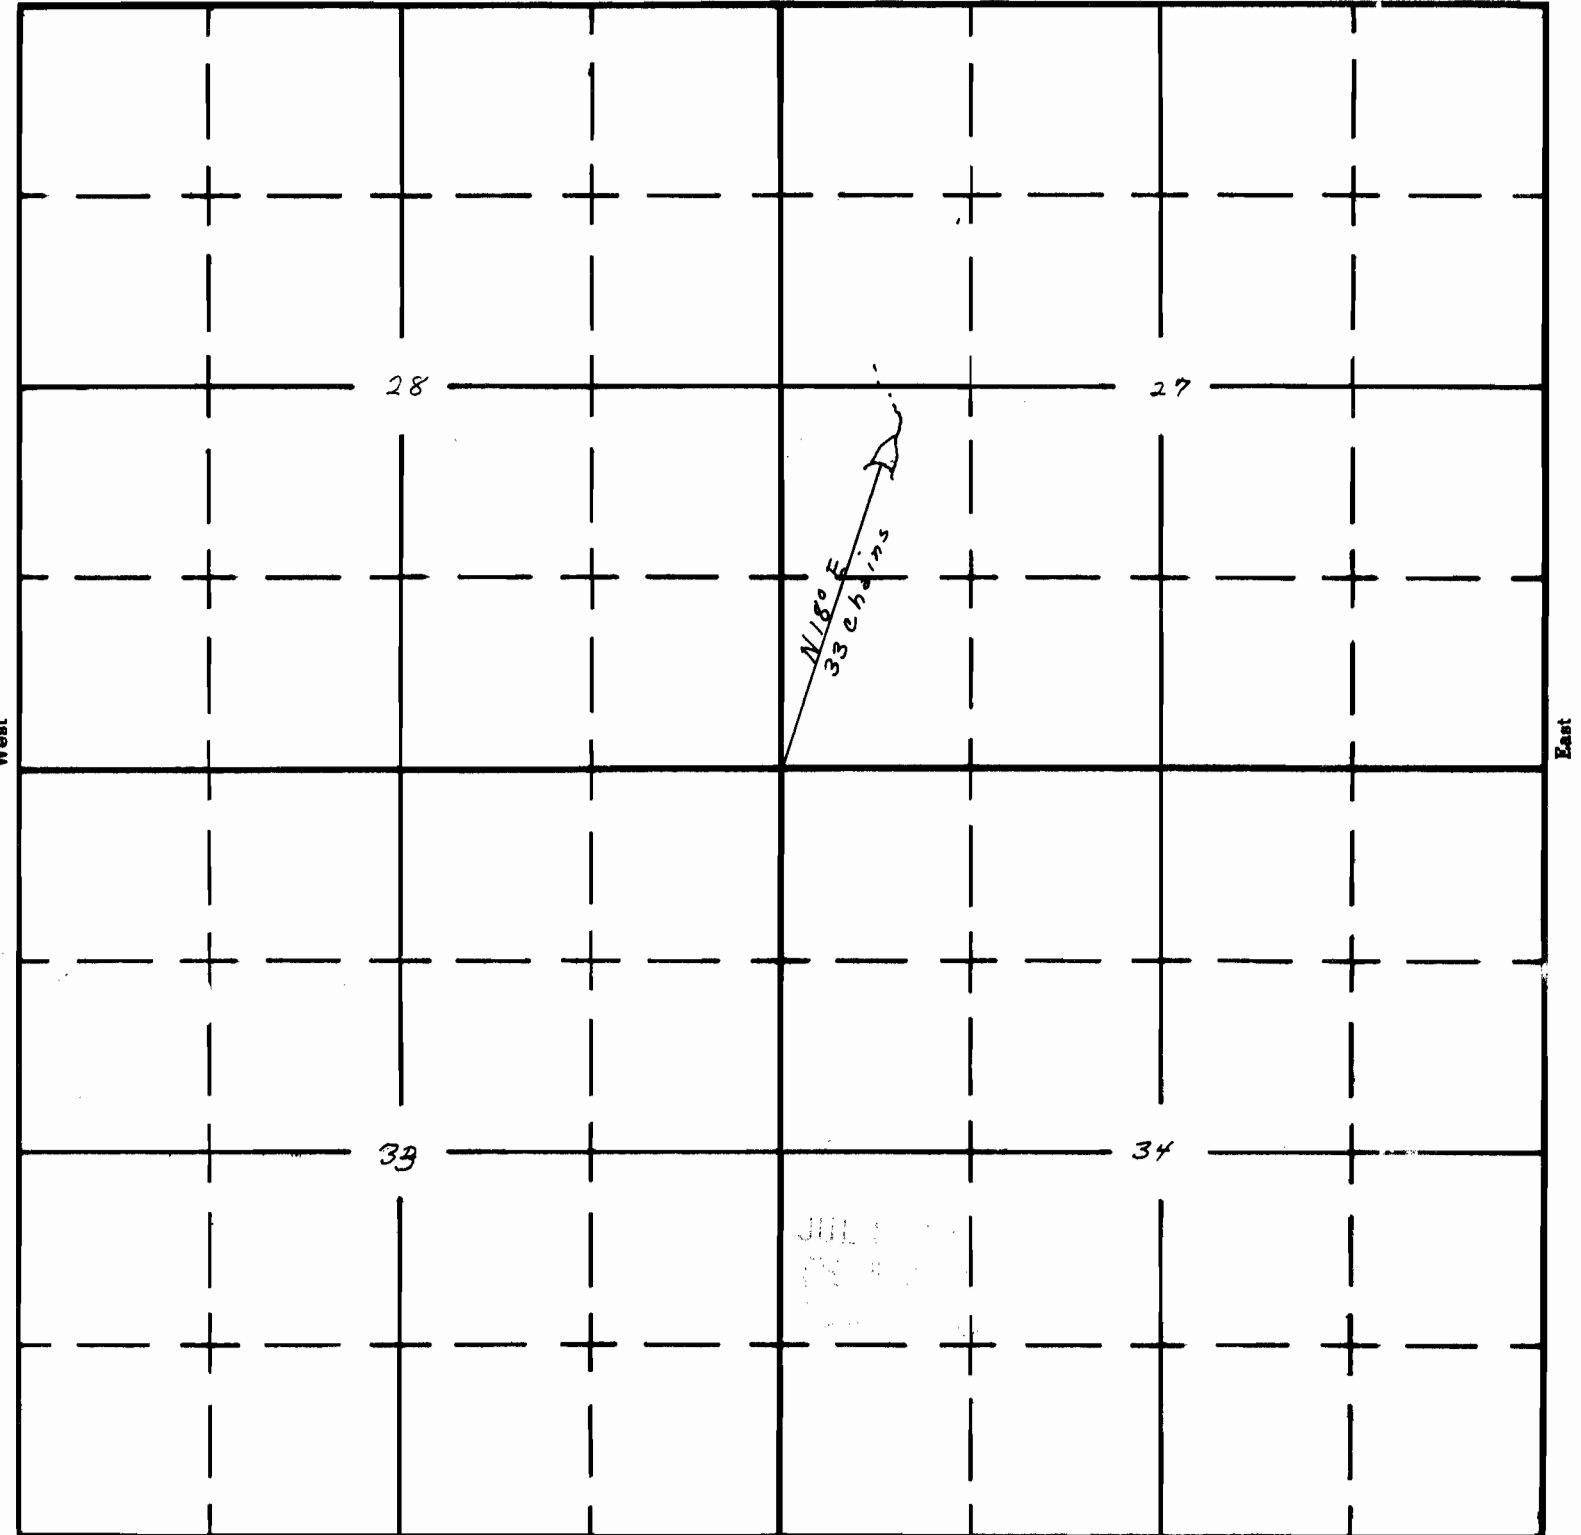

South

APPLICATION No. R-35173
PERMIT No. R-2967