

UNITED STATES
DEPARTMENT OF THE INTERIOR
BUREAU OF LAND MANAGEMENT

SECTION
29

Oregon State Water Filings

SW 1/4 SW 1/4


TOWNSHIP 39S, RANGE 23E, W. M.

TIED-IN WITH AERIAL PHOTOS
& O.S.H.D. QUAD MAPS

North

West

East

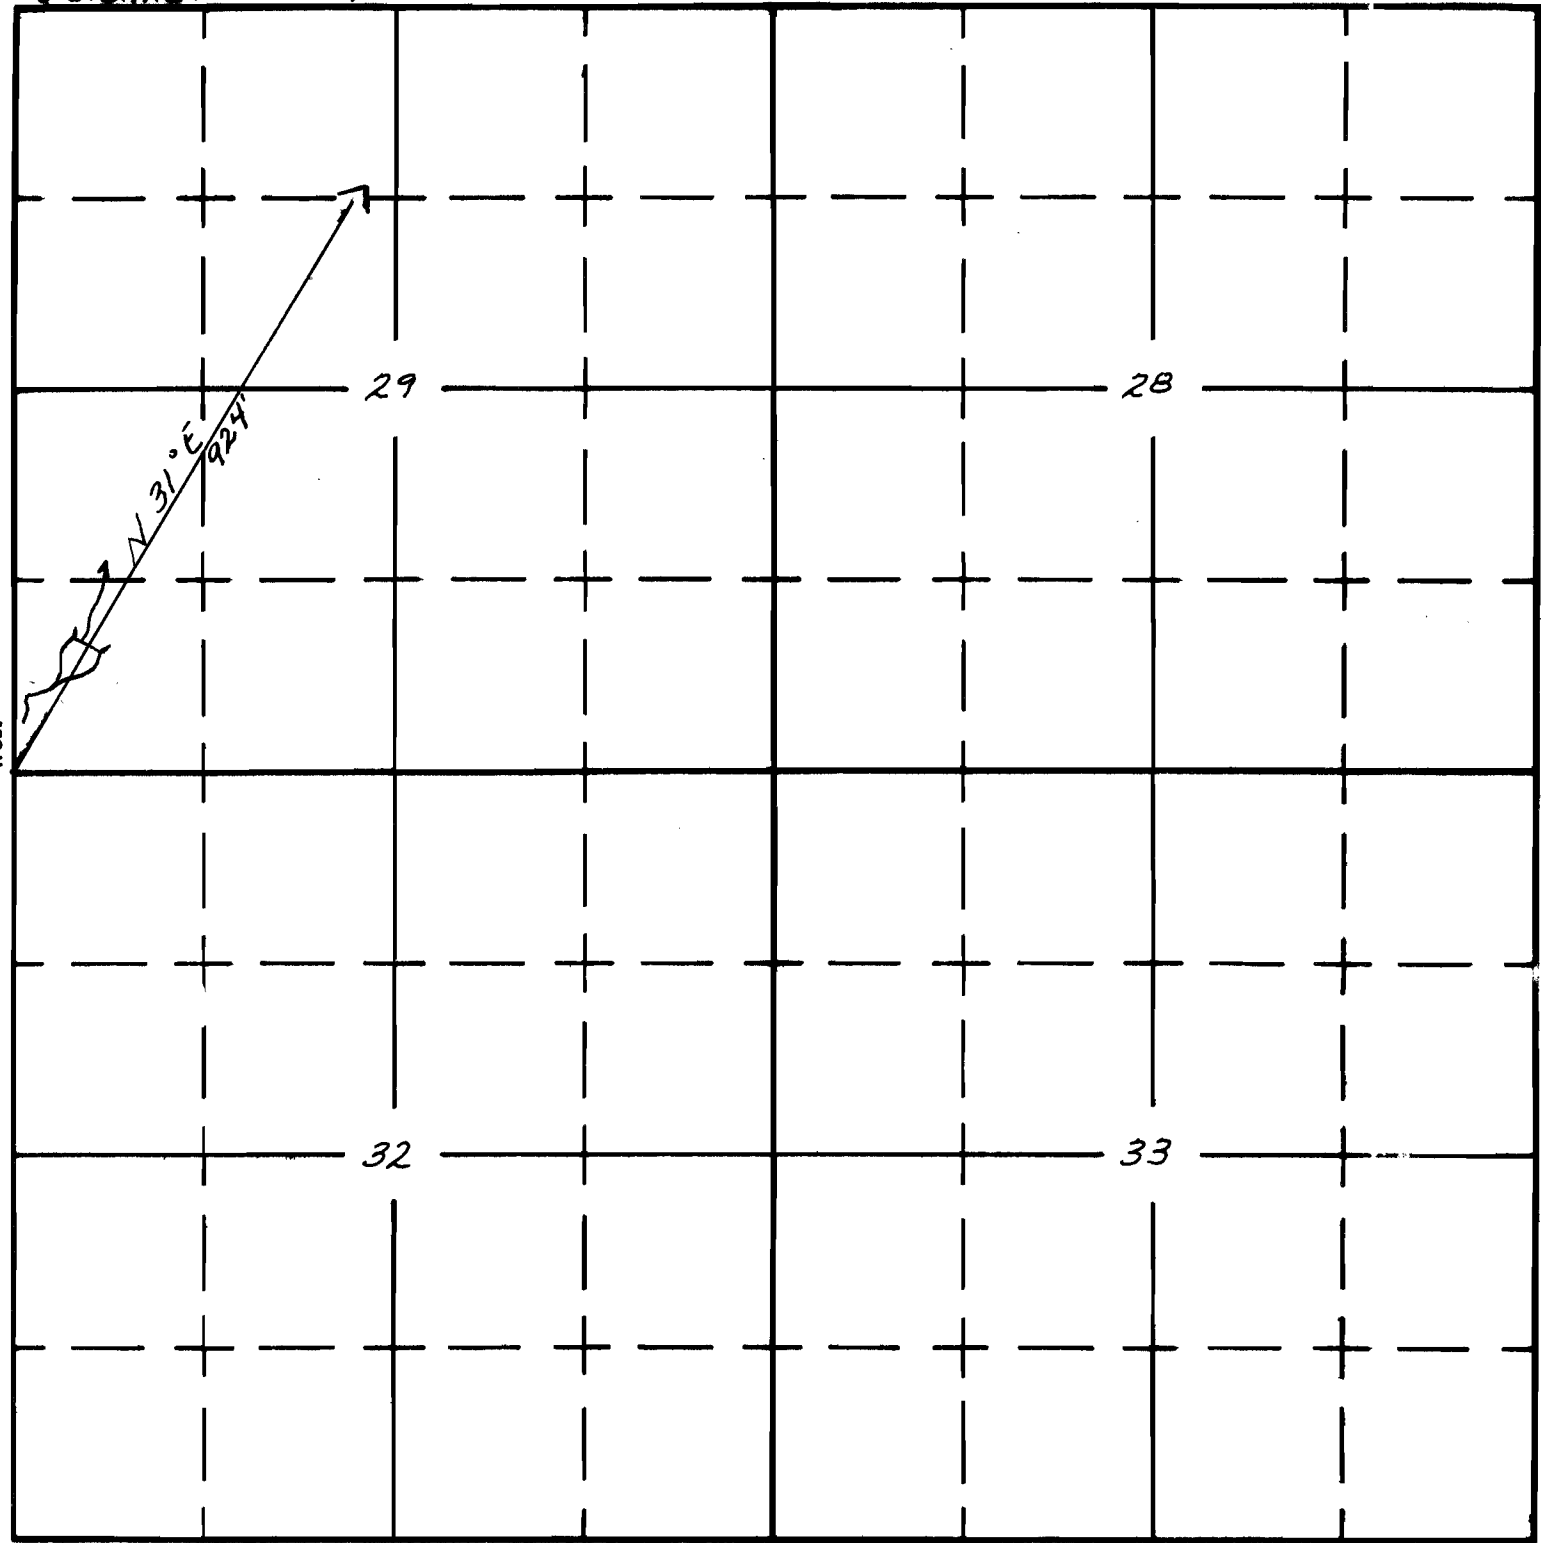

South