


RECEIVED
 U.S. DEPARTMENT OF THE INTERIOR
 BUREAU OF LAND MANAGEMENT
 OREGON

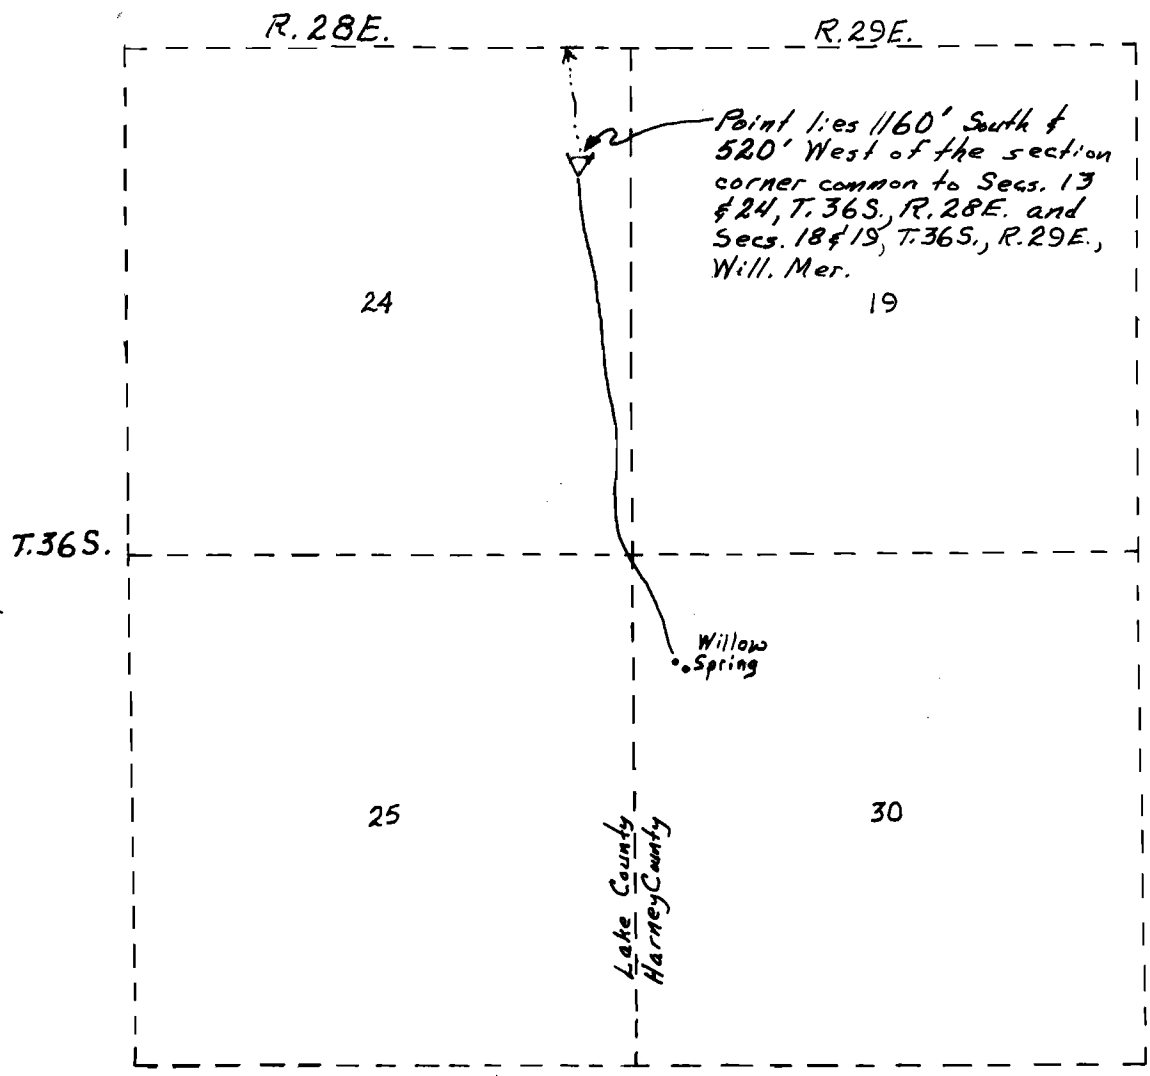

U. S. DEPARTMENT OF THE INTERIOR	
BUREAU OF LAND MANAGEMENT	
LAKEVIEW DISTRICT	OREGON
M.C. Reservoir No. 5	
Project No. 0143	
SCALE 1 inch = 2000 Feet	
DATE 9-7-78	SHEET 1 OF 1
DRAWING NO.	