

UNITED STATES
DEPARTMENT OF THE INTERIOR
BUREAU OF LAND MANAGEMENT

SECTION


9

NE 1/4 NW 1/4

Oregon State Water Filings

TOWNSHIP 35S, RANGE 22E, W. M.

North

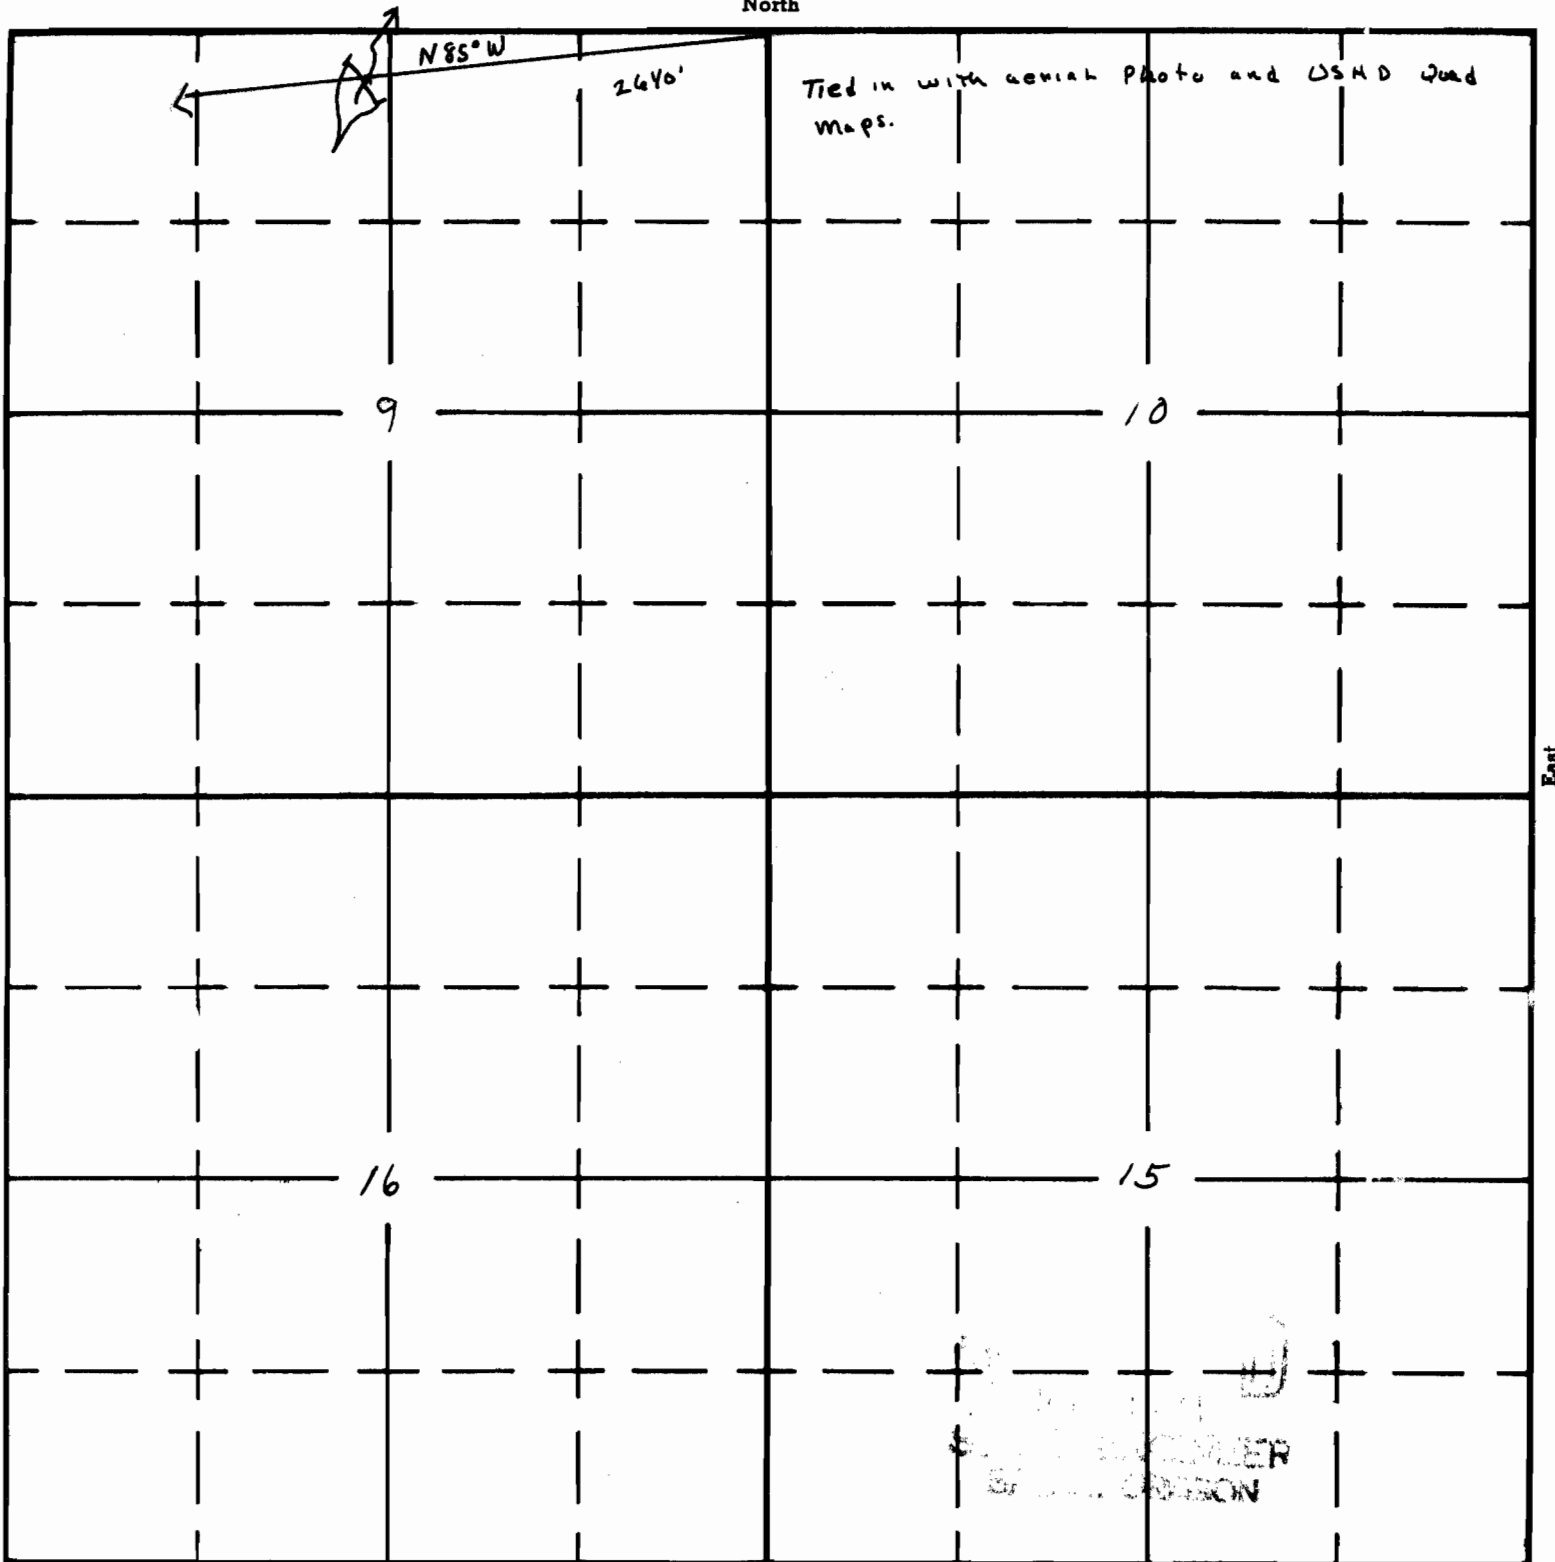

South

APPLICATION No. R-35289
PERMIT No. R-3046