

Form A1-187
March 1961


UNITED STATES
DEPARTMENT OF THE INTERIOR
BUREAU OF LAND MANAGEMENT

SECTION

SW 1/4 Oregon State Water Filings

11 TOWNSHIP 24S, RANGE 23E, W. M.

North

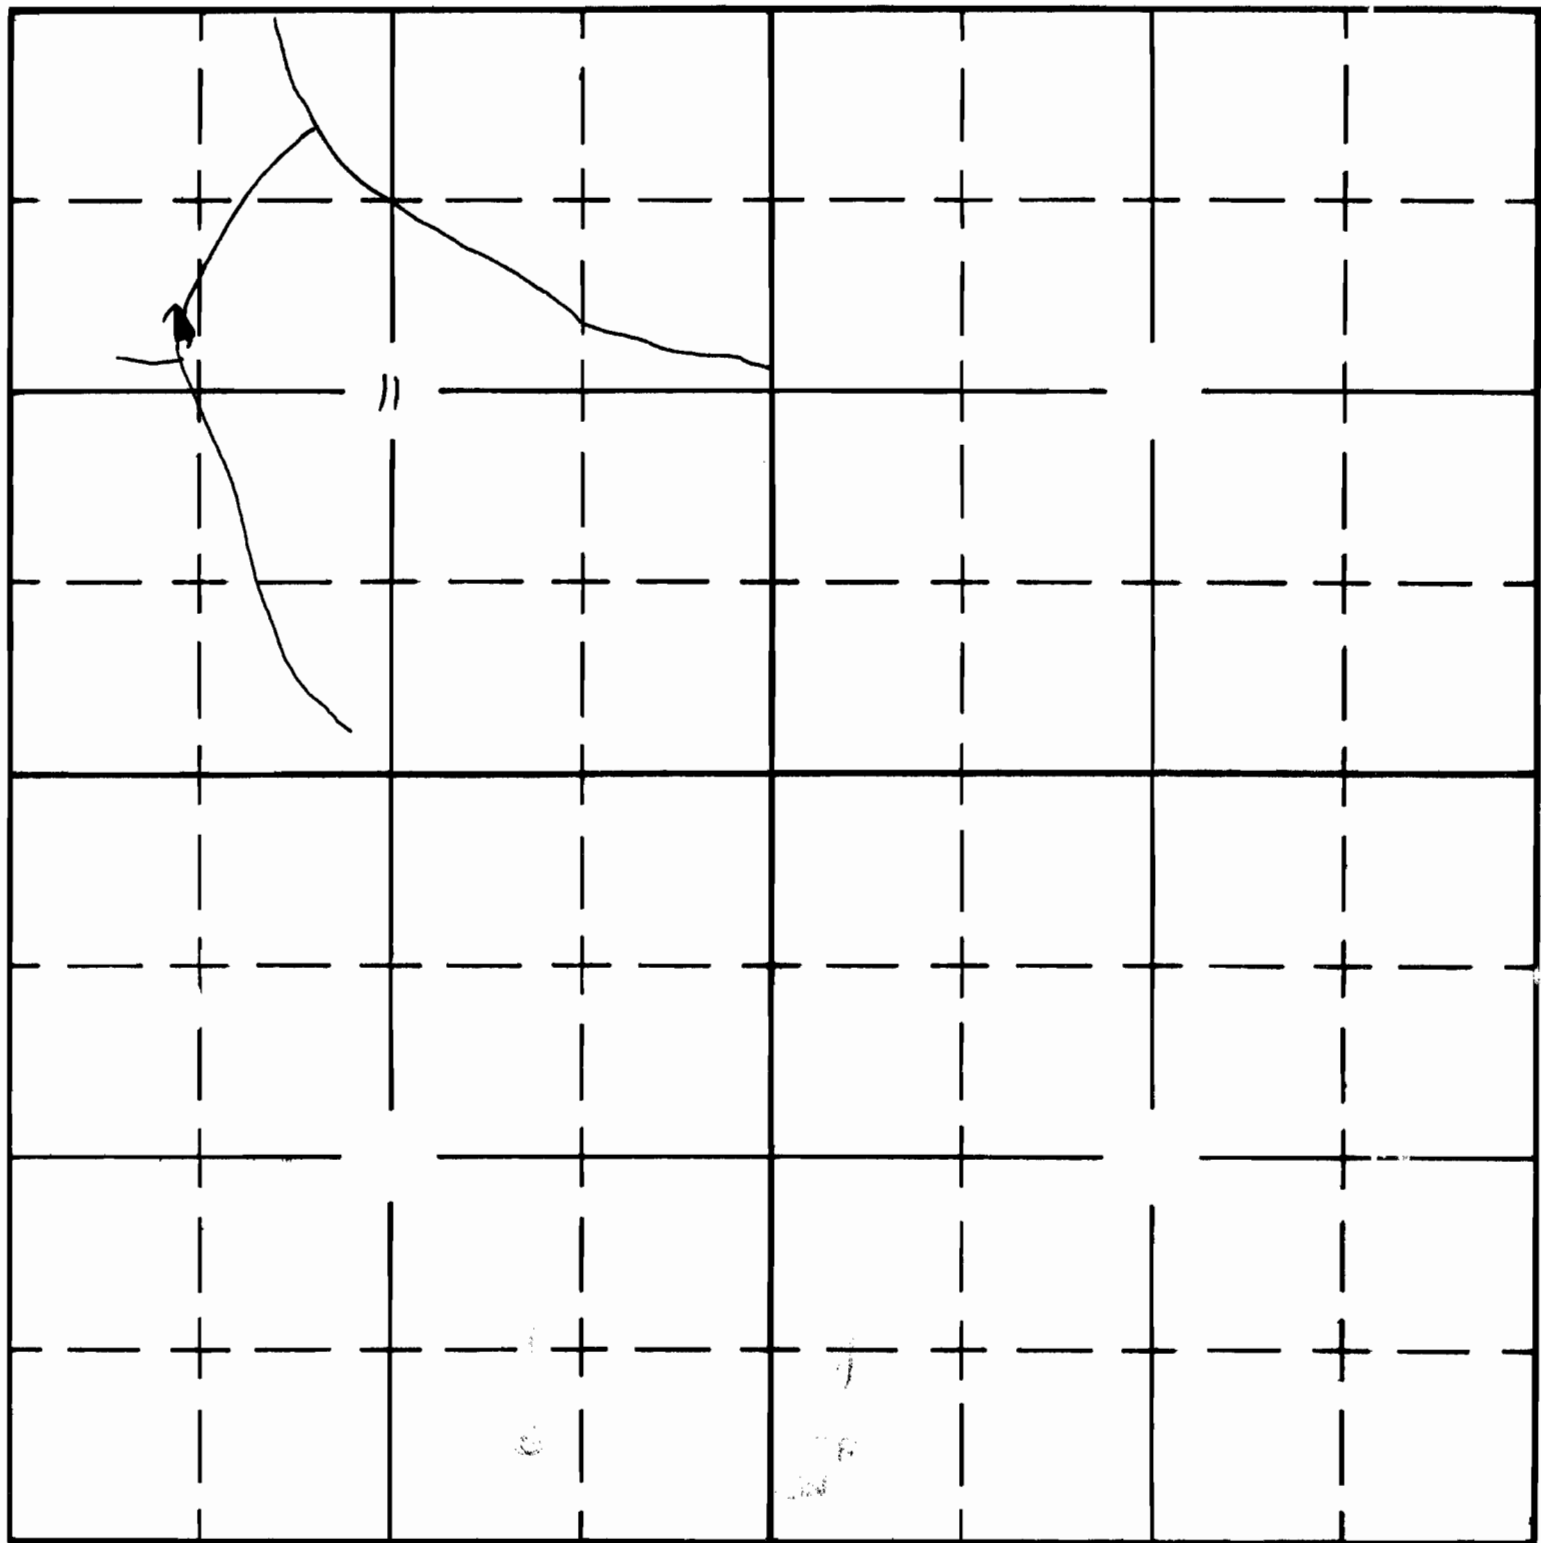

South

APPLICATION No. R-35312
PERMIT No. R-3115