

UNITED STATES
DEPARTMENT OF THE INTERIOR
BUREAU OF LAND MANAGEMENT

SECTION


SE 1/4 SE 1/4

Oregon State Water Filings

4

TOWNSHIP 24S, RANGE 23E, W. M.

North

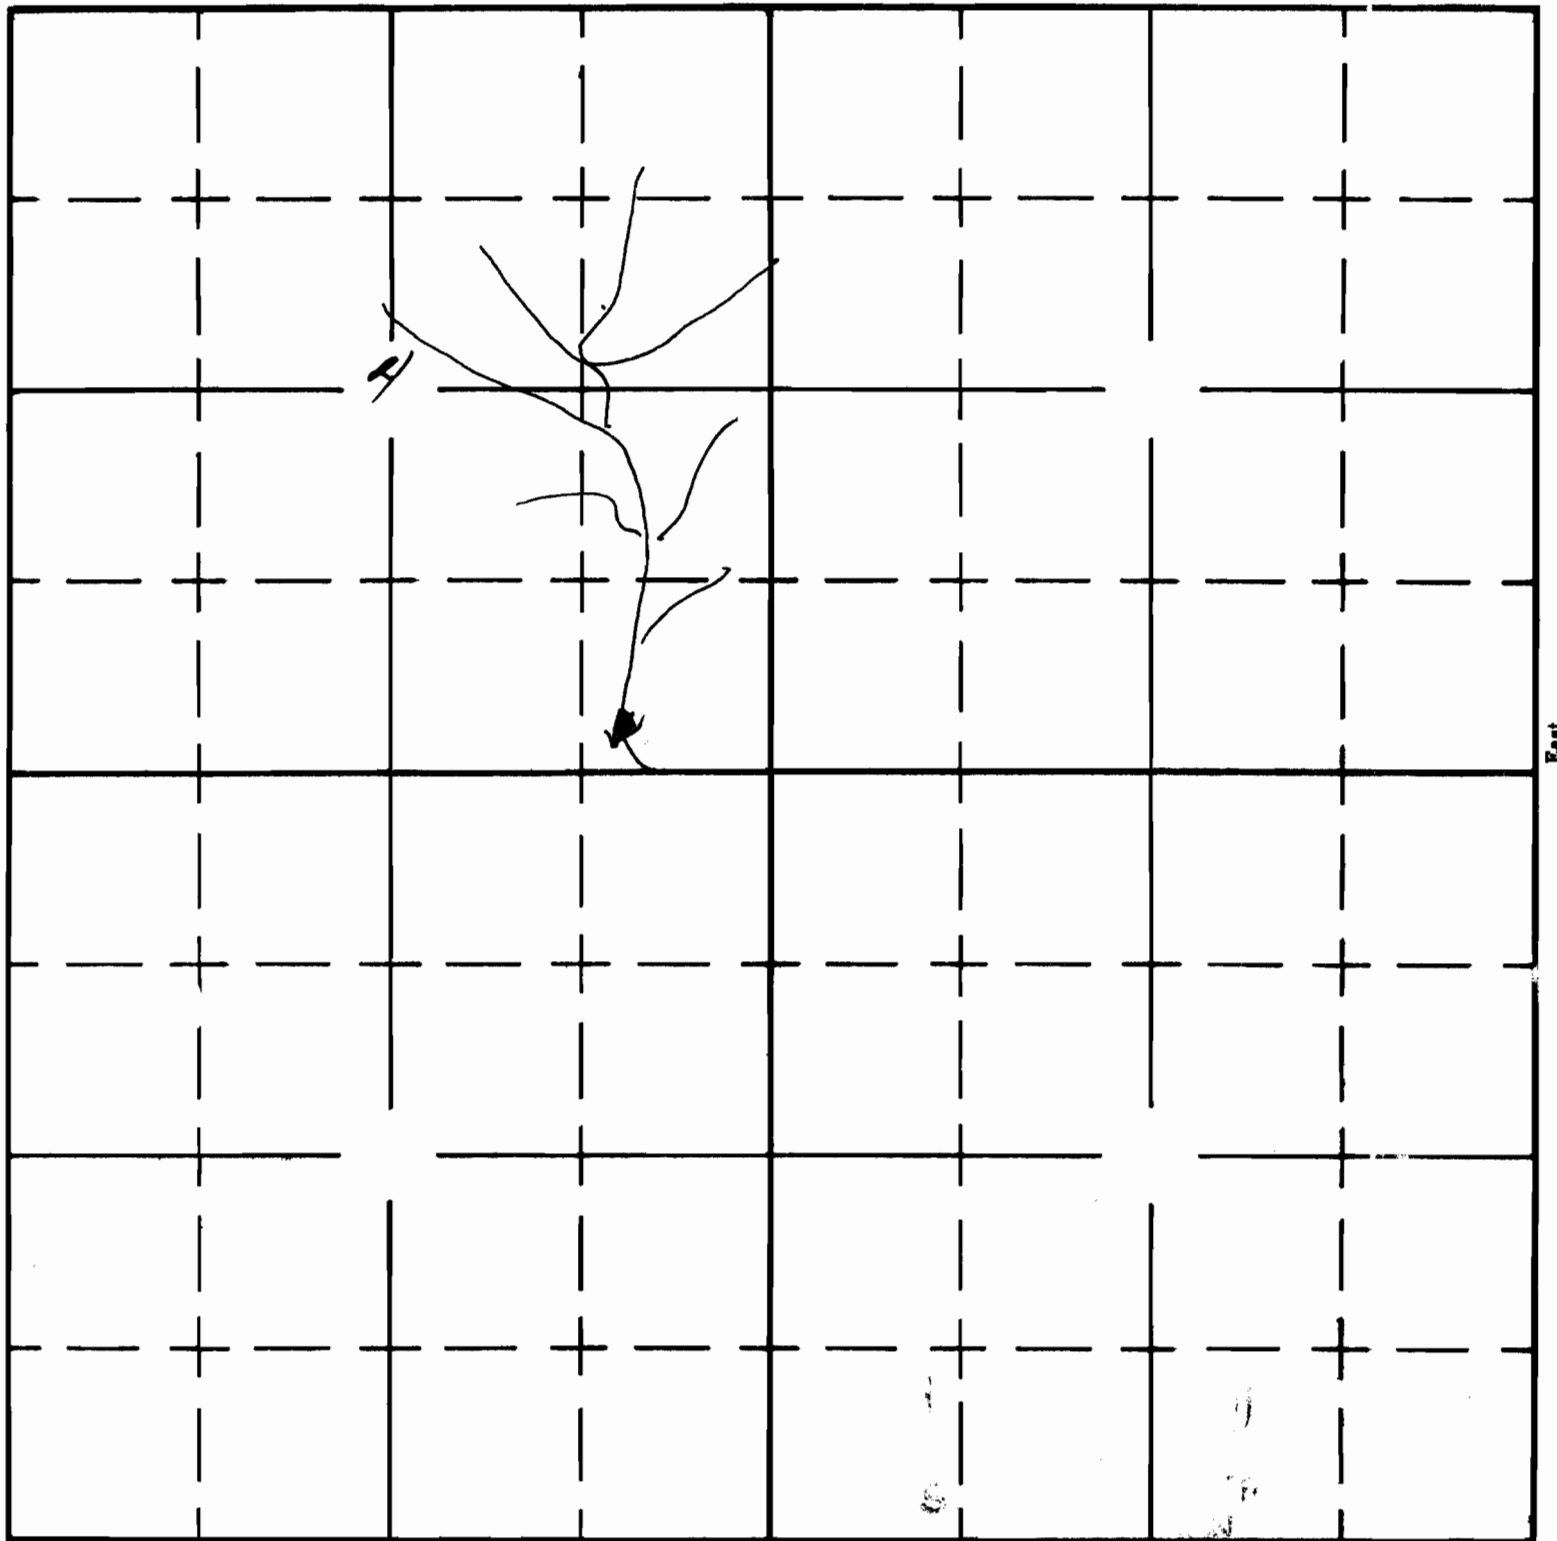

South

APPLICATION No. R-35373
PERMIT No. R-3116