

Form AI-187
March 1961

UNITED STATES
DEPARTMENT OF THE INTERIOR
BUREAU OF LAND MANAGEMENT

SECTION


NW 1/4 SE 1/4

Oregon State Water Filings

SEC. 12

TOWNSHIP 40 S, RANGE 32 E, W. M.

North

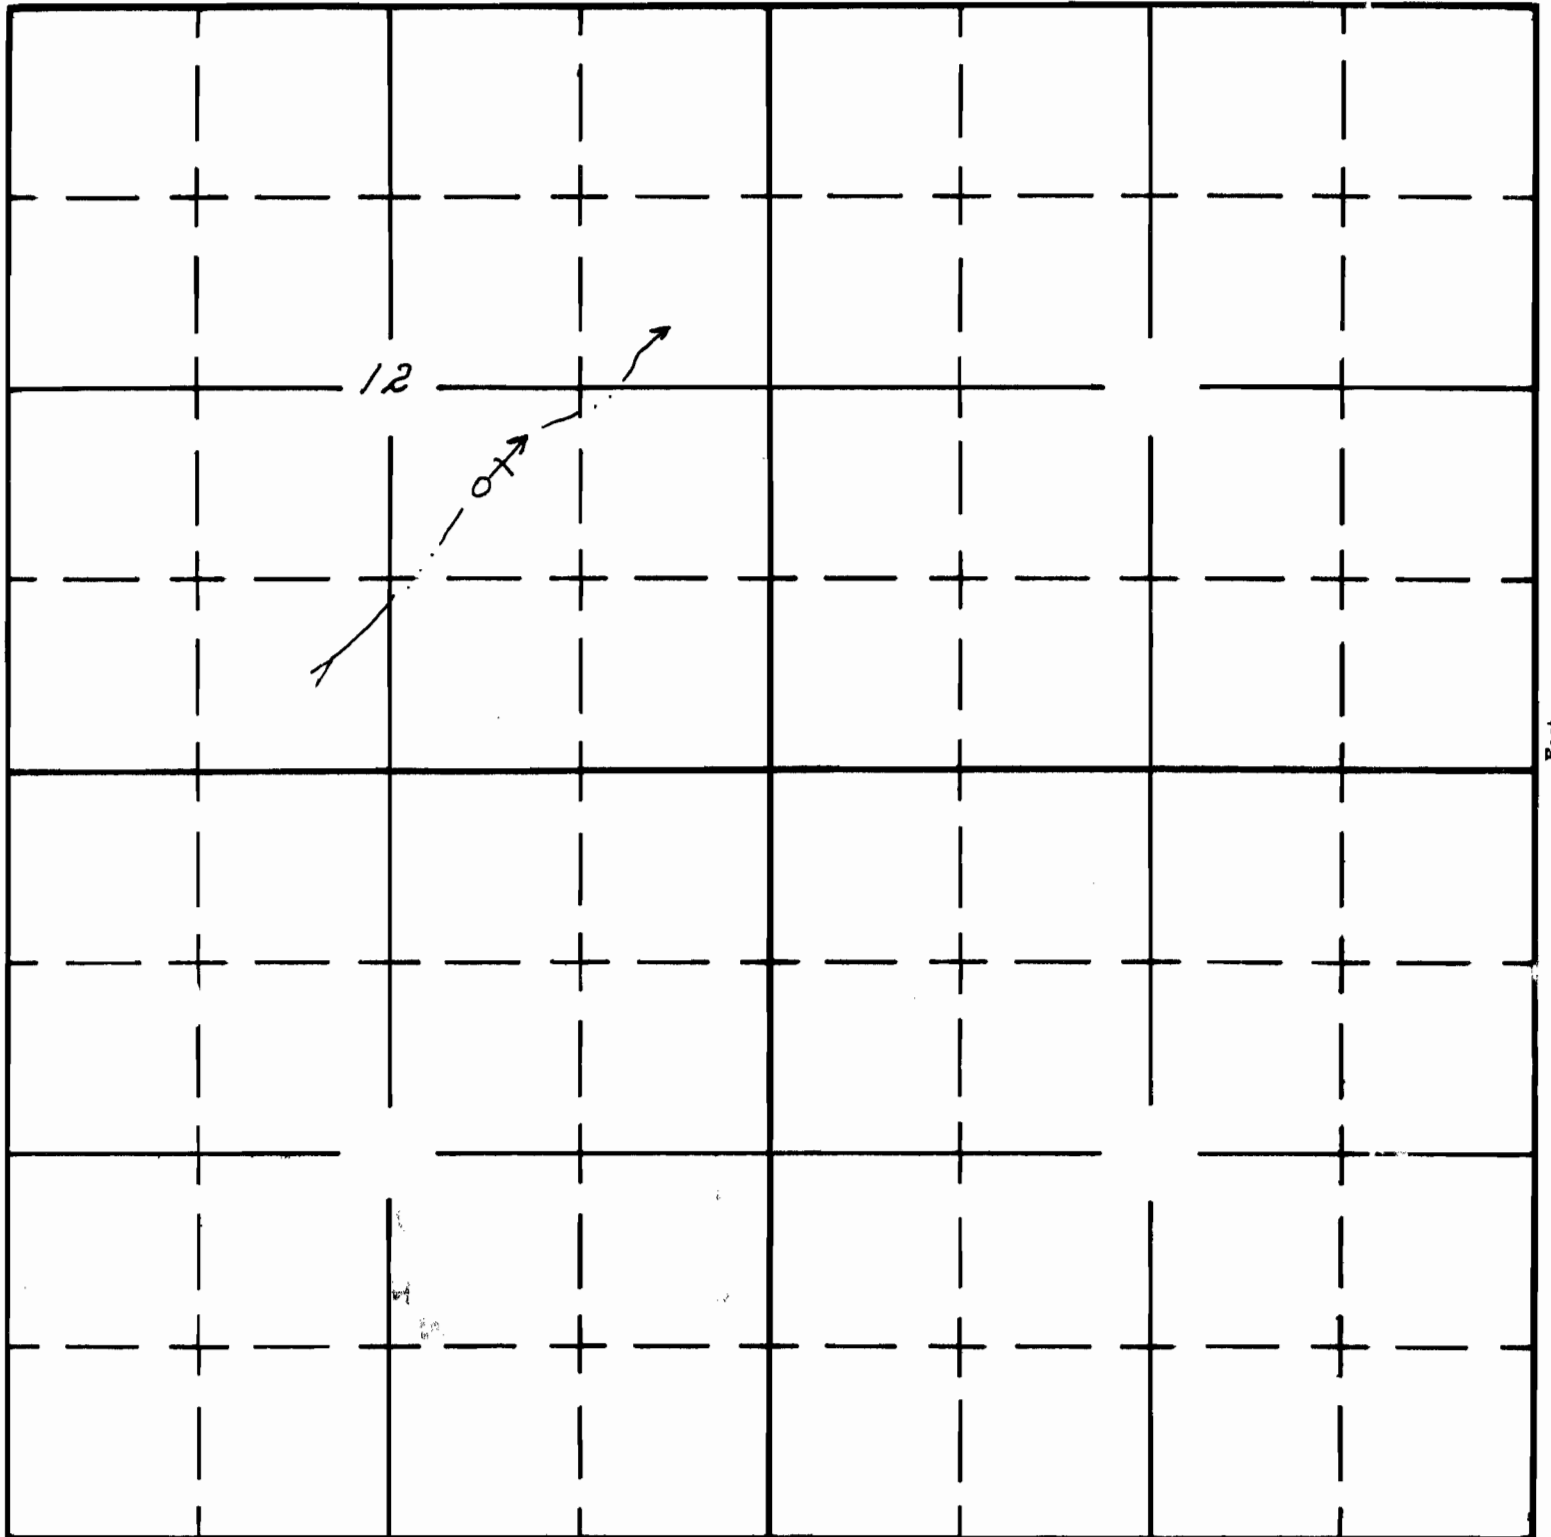

South

APPLICATION No. R-35381
PERMIT No. R-3124