

Form AI-187
March 1961

UNITED STATES
DEPARTMENT OF THE INTERIOR
BUREAU OF LAND MANAGEMENT

SECTION


SE 1/4 NE 1/4

Oregon State Water Filings

35

TOWNSHIP 22 S, RANGE 24 E, W. M.

North

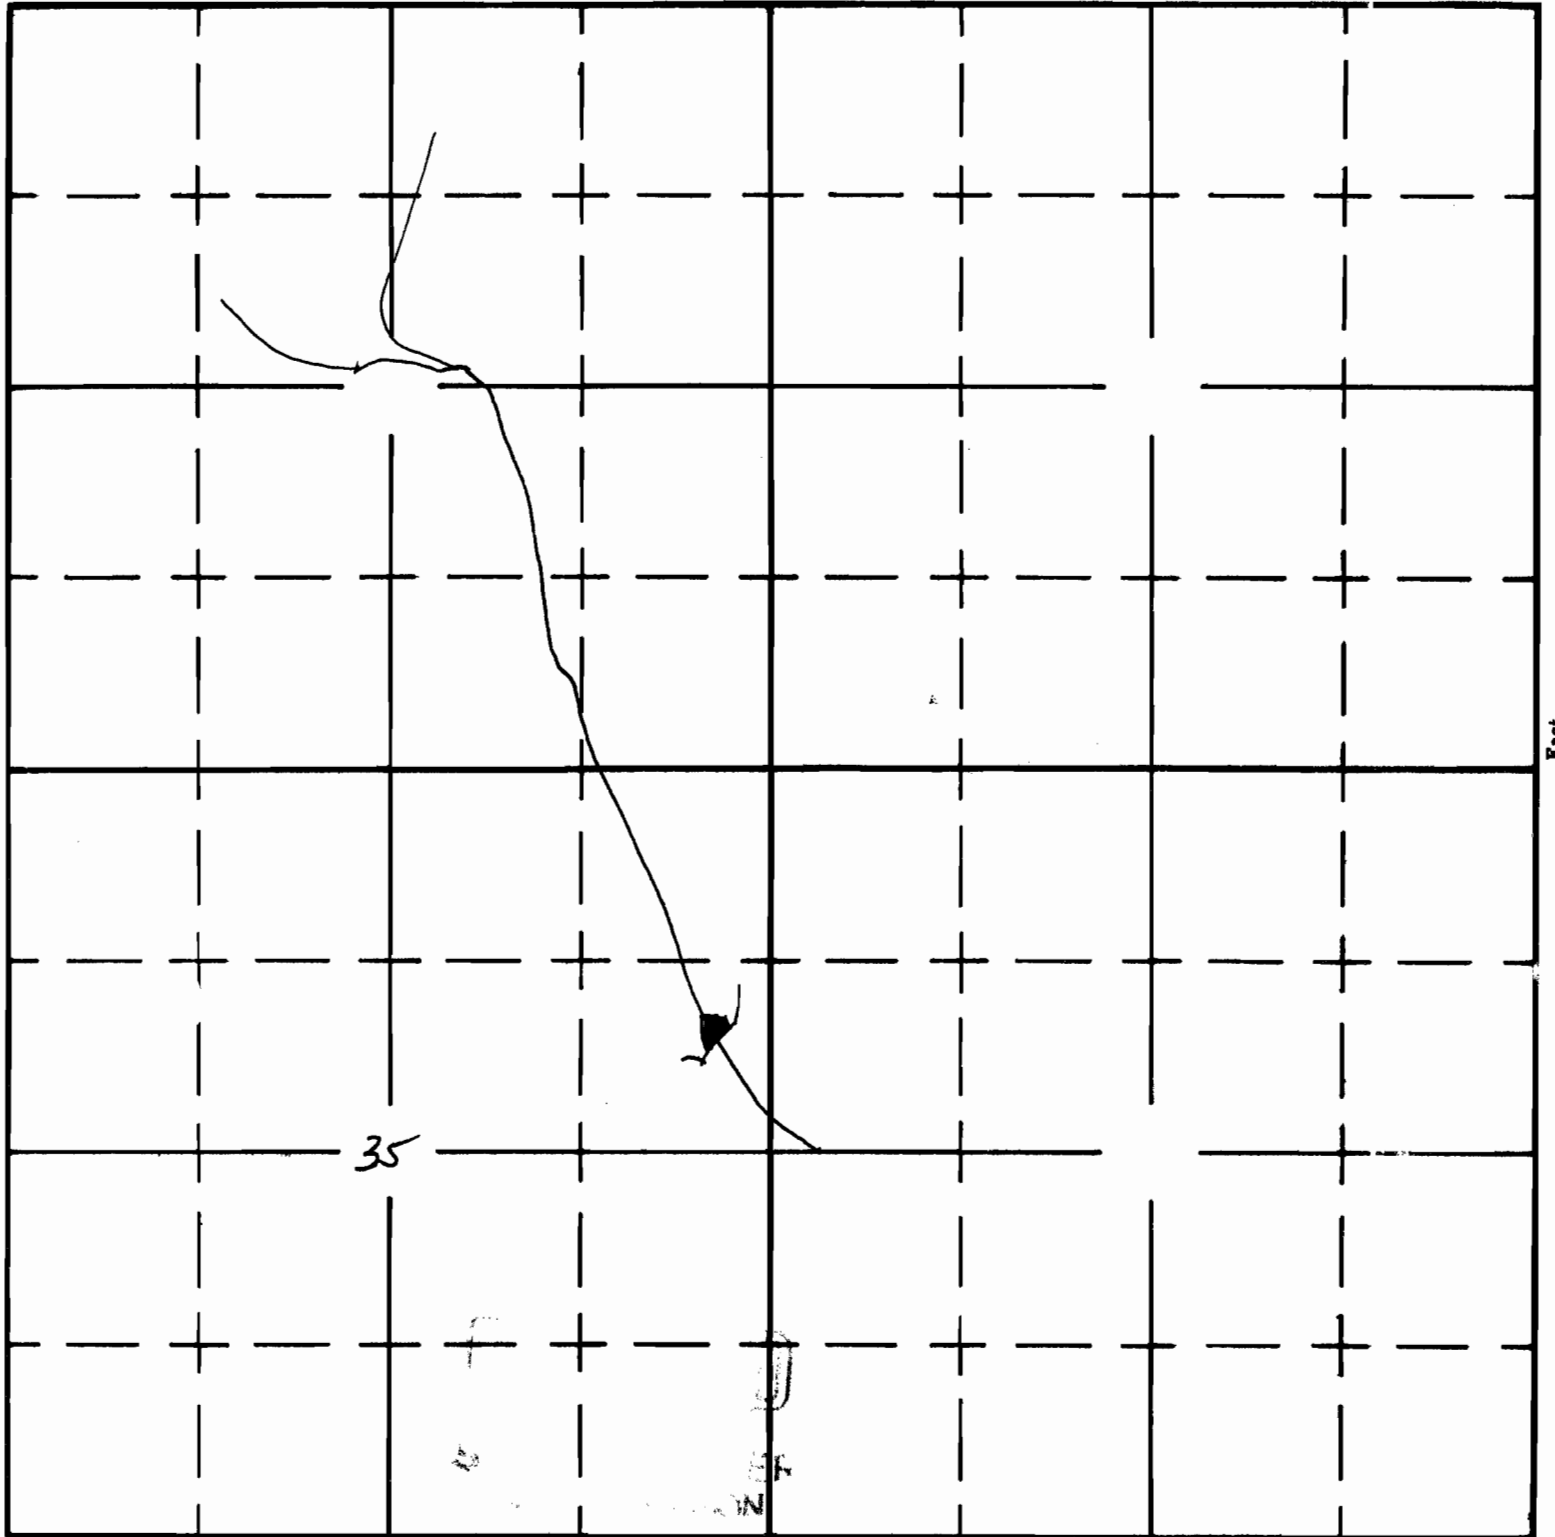

South

APPLICATION No. R-35330

PERMIT No. R-3148