

UNITED STATES
DEPARTMENT OF THE INTERIOR
BUREAU OF LAND MANAGEMENT

SECTION


SE 1/4 NW 1/4

Oregon State Water Filings

26

TOWNSHIP 22 S, RANGE 24 E, W. M.

North

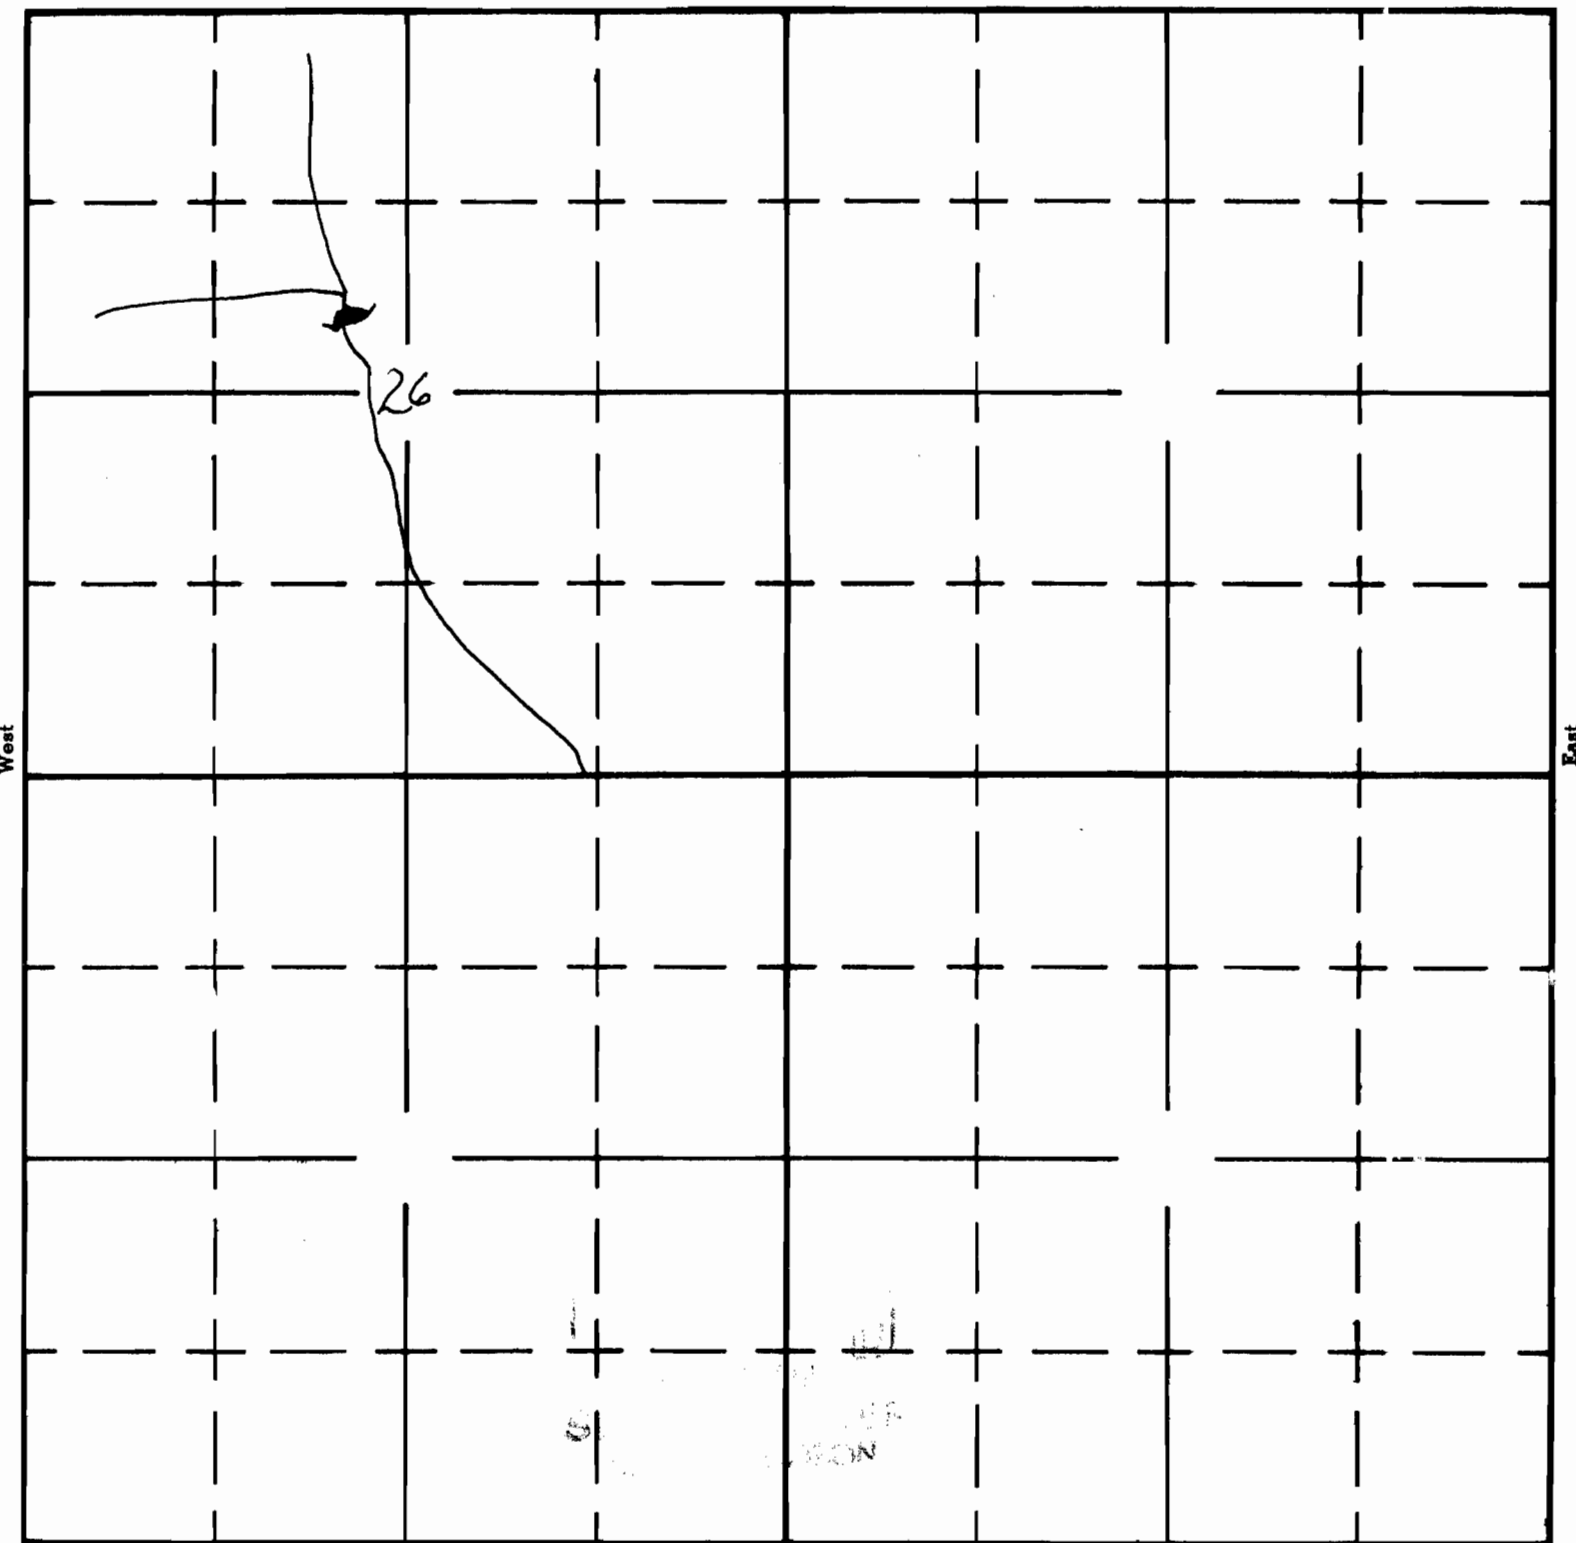

APPLICATION No. R-35331
PERMIT No. R-3149