

UNITED STATES
DEPARTMENT OF THE INTERIOR
BUREAU OF LAND MANAGEMENT

✓ R-3233
62819

SECTION


29
NW 1/4 SE 1/4

Oregon State Water Filings

TOWNSHIP 40S, RANGE 4E, W. M.

Oregon Gulch Res. #1
North

primary file: Misc

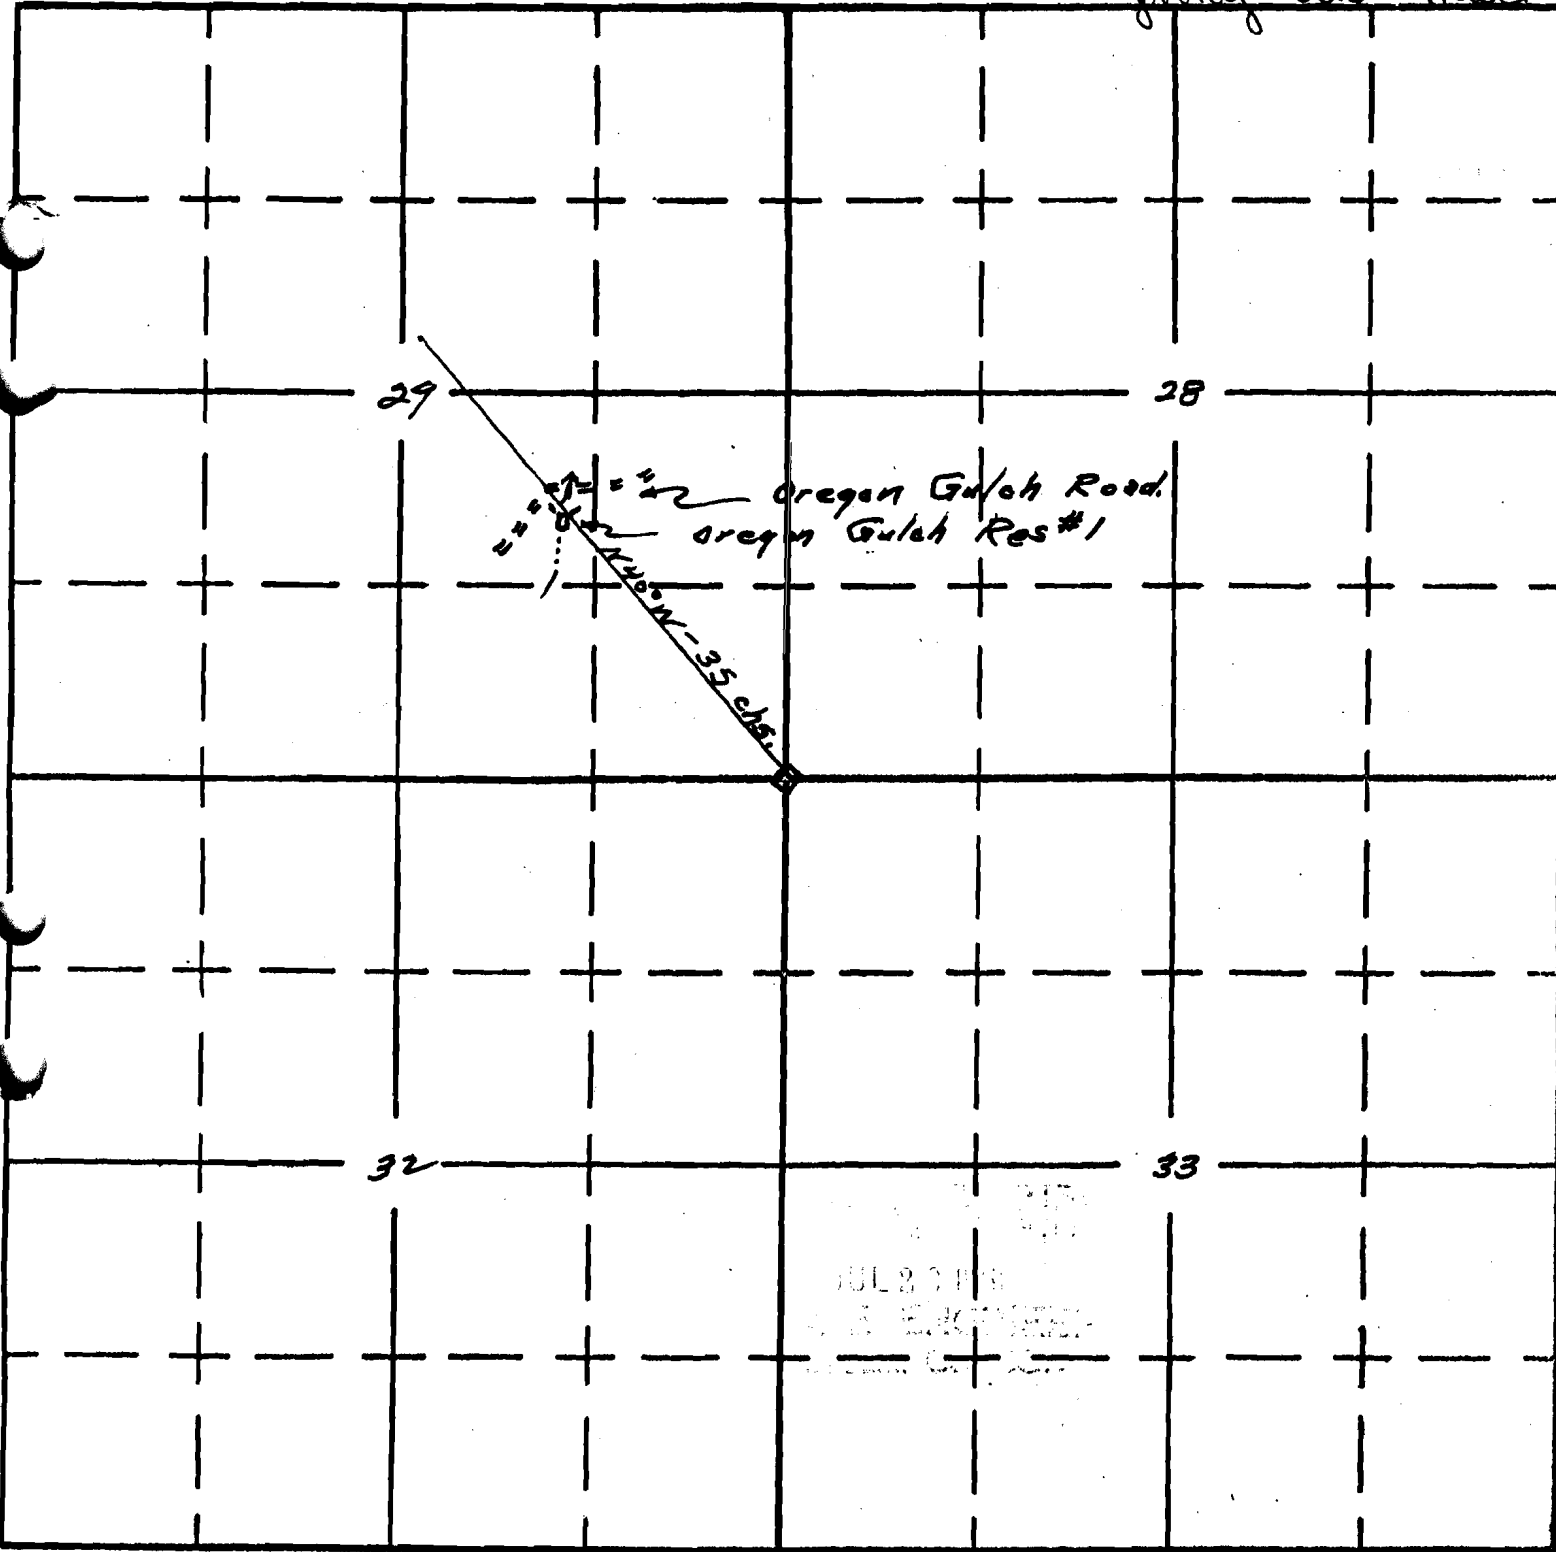

West

South

APPLICATION No. R-35214

PERMIT No. R-3233