

UNITED STATES  
DEPARTMENT OF THE INTERIOR  
BUREAU OF LAND MANAGEMENT

SECTION


3

SW 1/4 NE 1/4


TOWNSHIP 41S, RANGE 2E, W. M.

*Porcupine Reservoir*  
North  Con found,

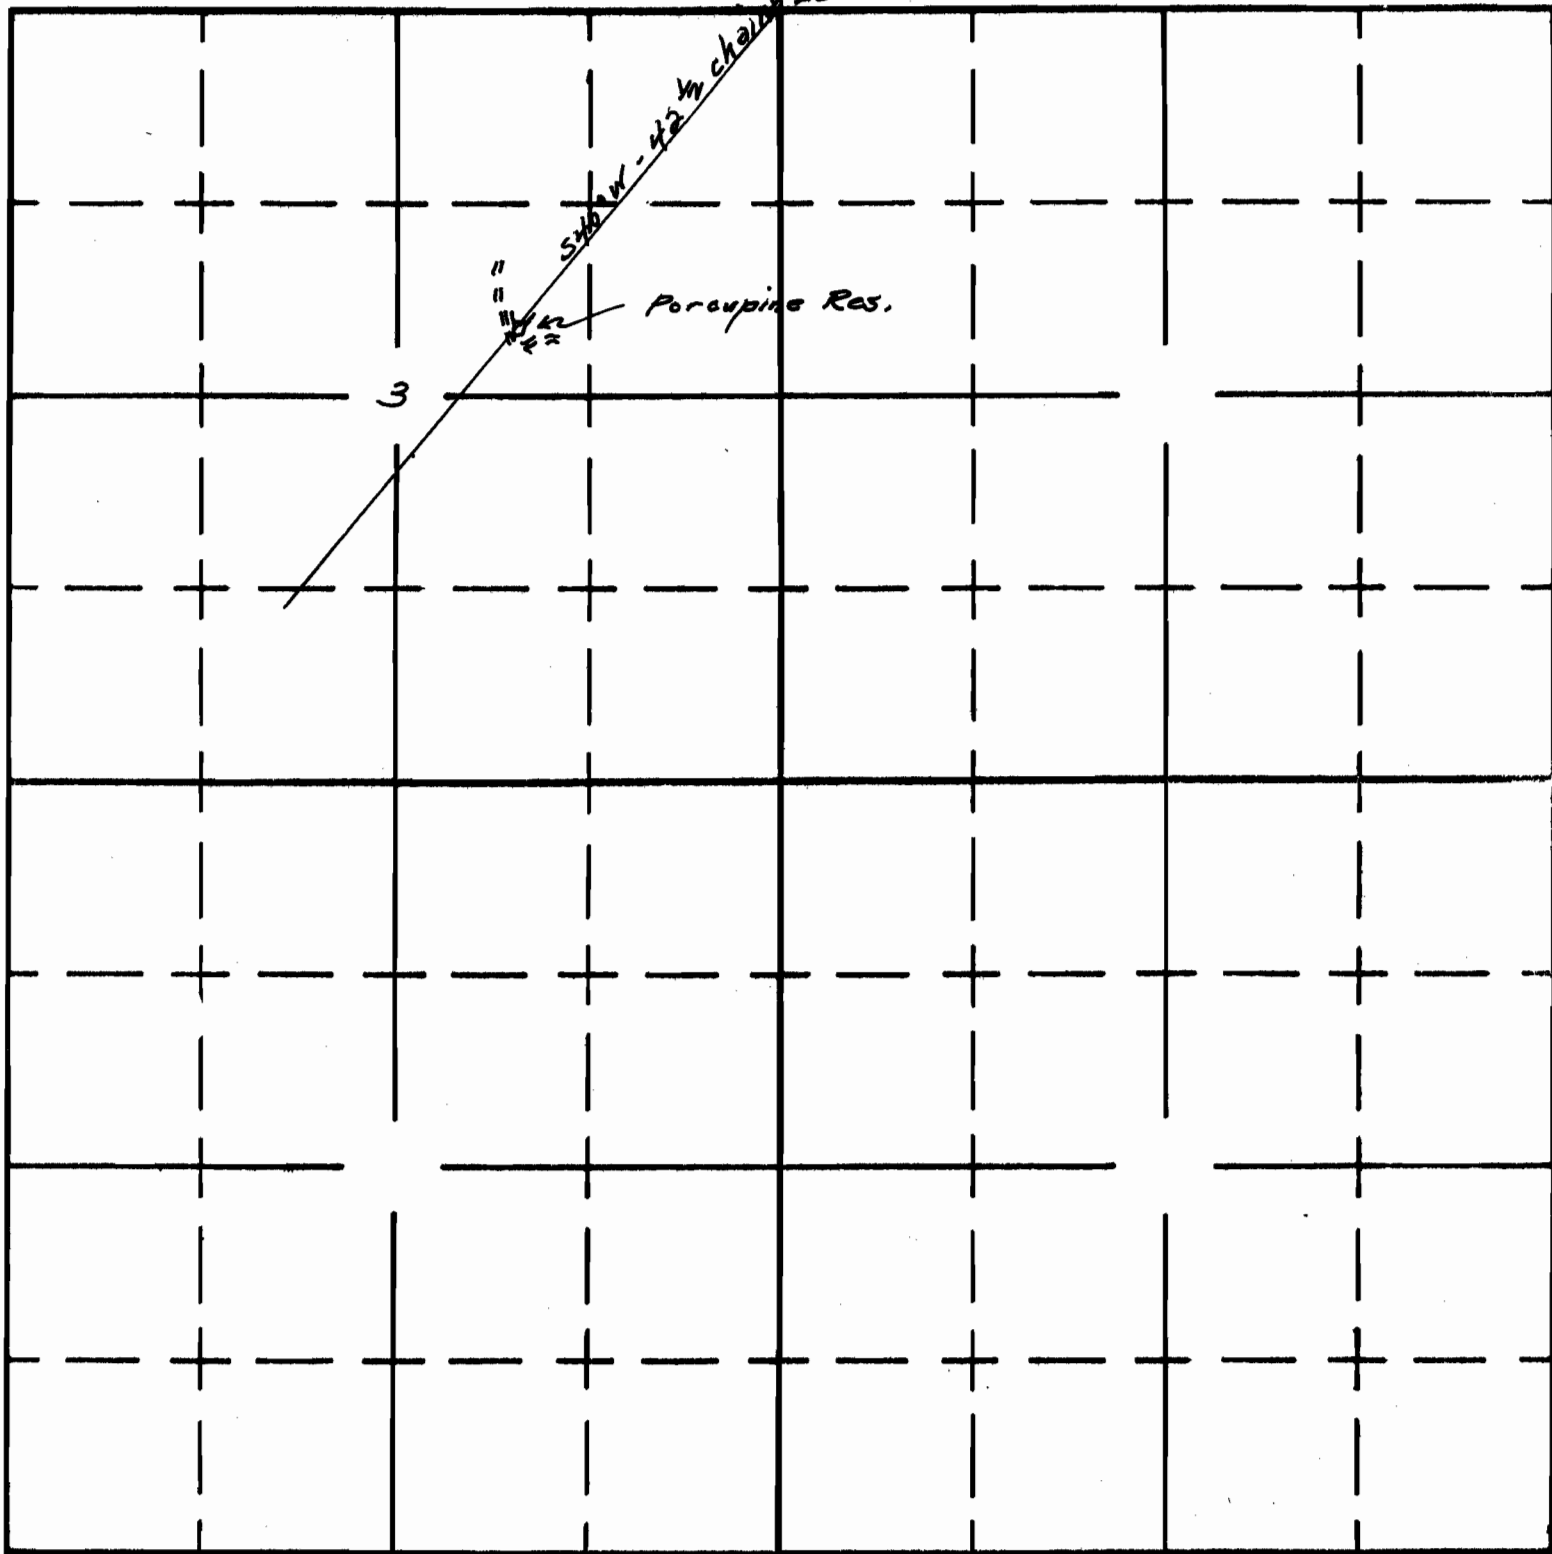

South

APPLICATION No. R-35220  
PERMIT No. R-3239