

UNITED STATES
DEPARTMENT OF THE INTERIOR
BUREAU OF LAND MANAGEMENT

SECTION


33

NW⁴ NW⁴

Oregon State Water Filings

TOWNSHIP 38S, RANGE 3E, W. M.

Dead Indian Res.
North

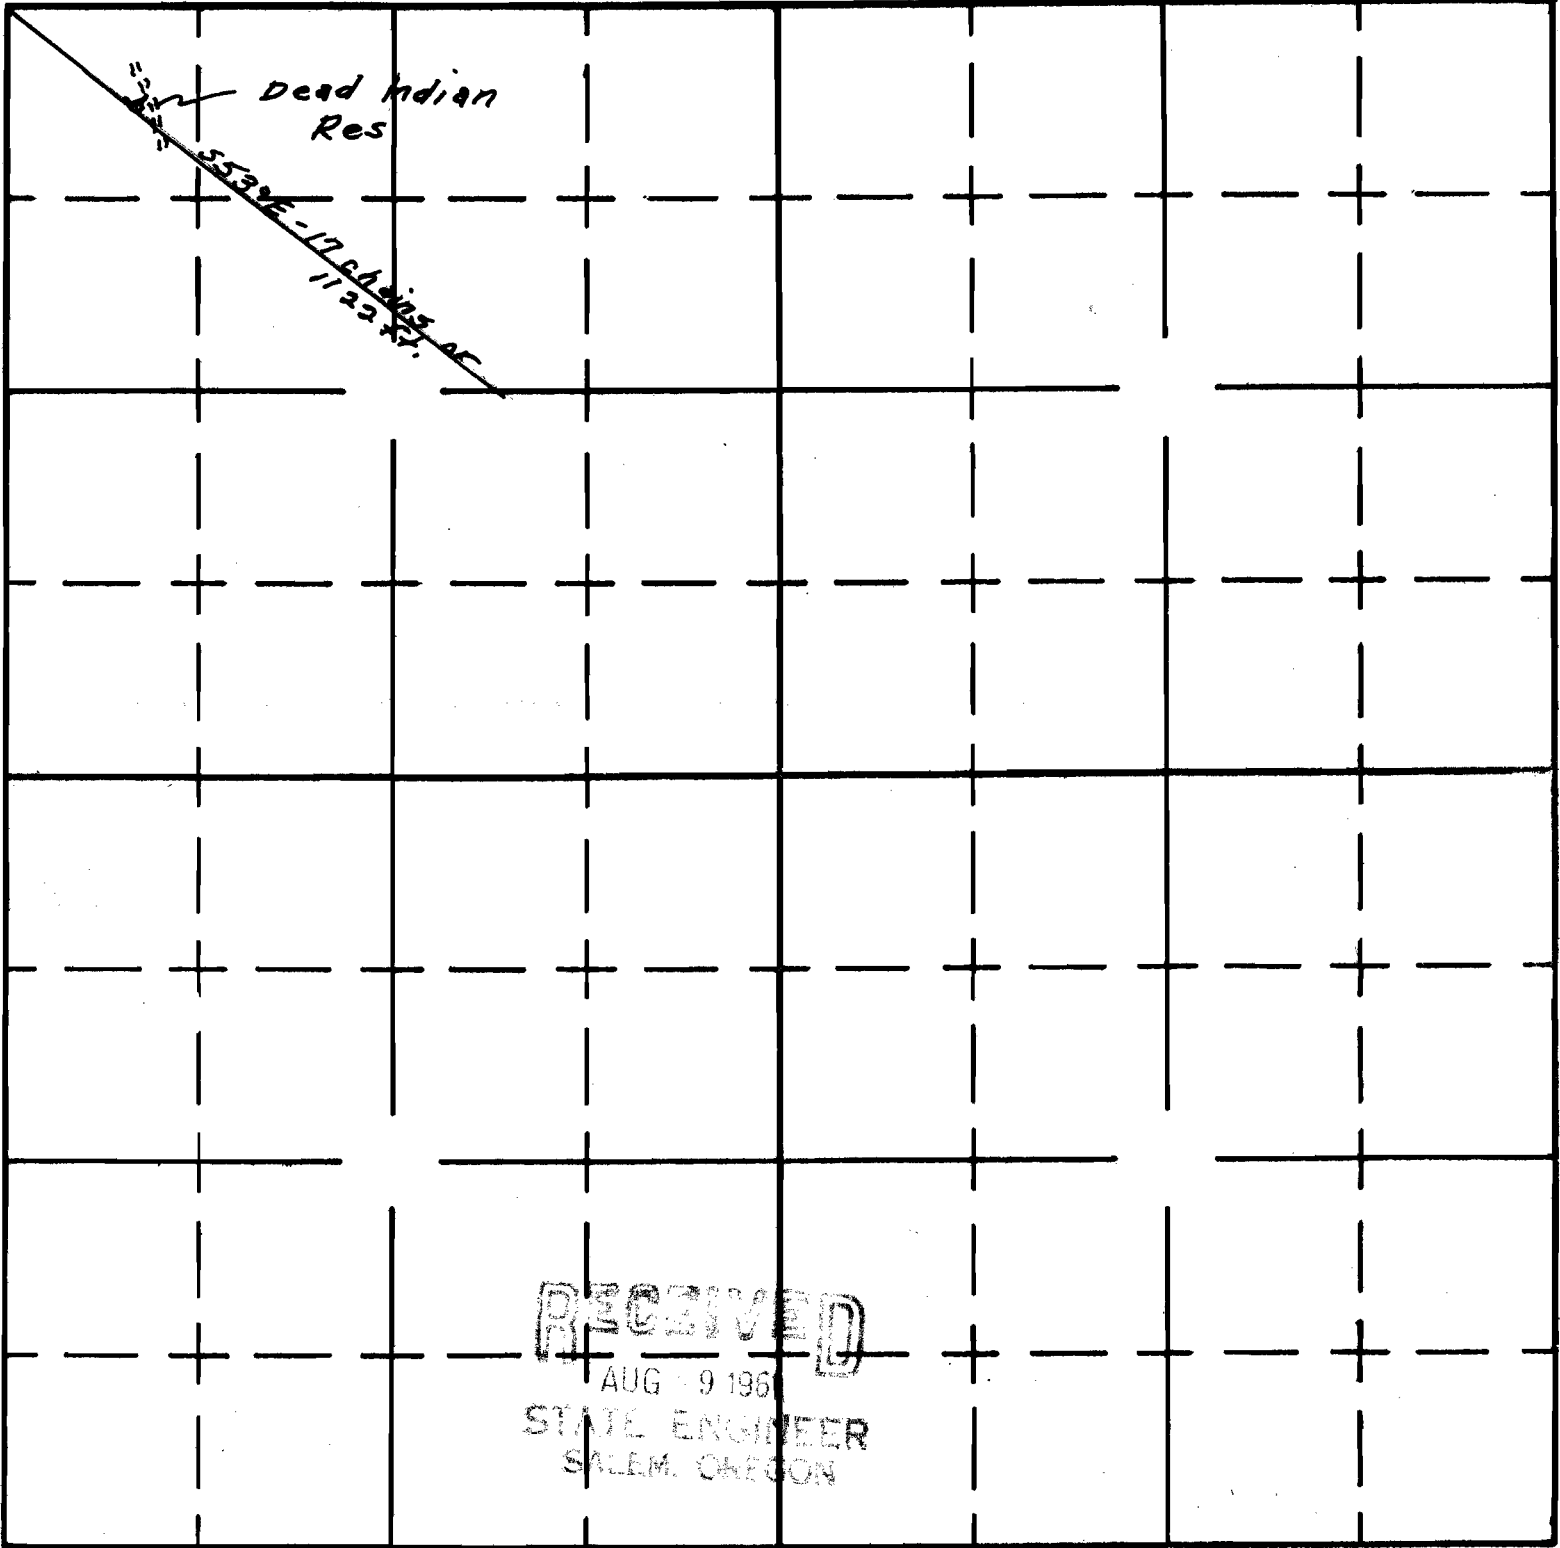

South

APPLICATION No. *R-36988*
PERMIT No. *R-3242*