

UNITED STATES
DEPARTMENT OF THE INTERIOR
BUREAU OF LAND MANAGEMENT

SECTION


17
SE 4 SE 4

Oregon State Water Filings

TOWNSHIP 39S, RANGE 3E, W. M.

Burnt Creek Res.

North

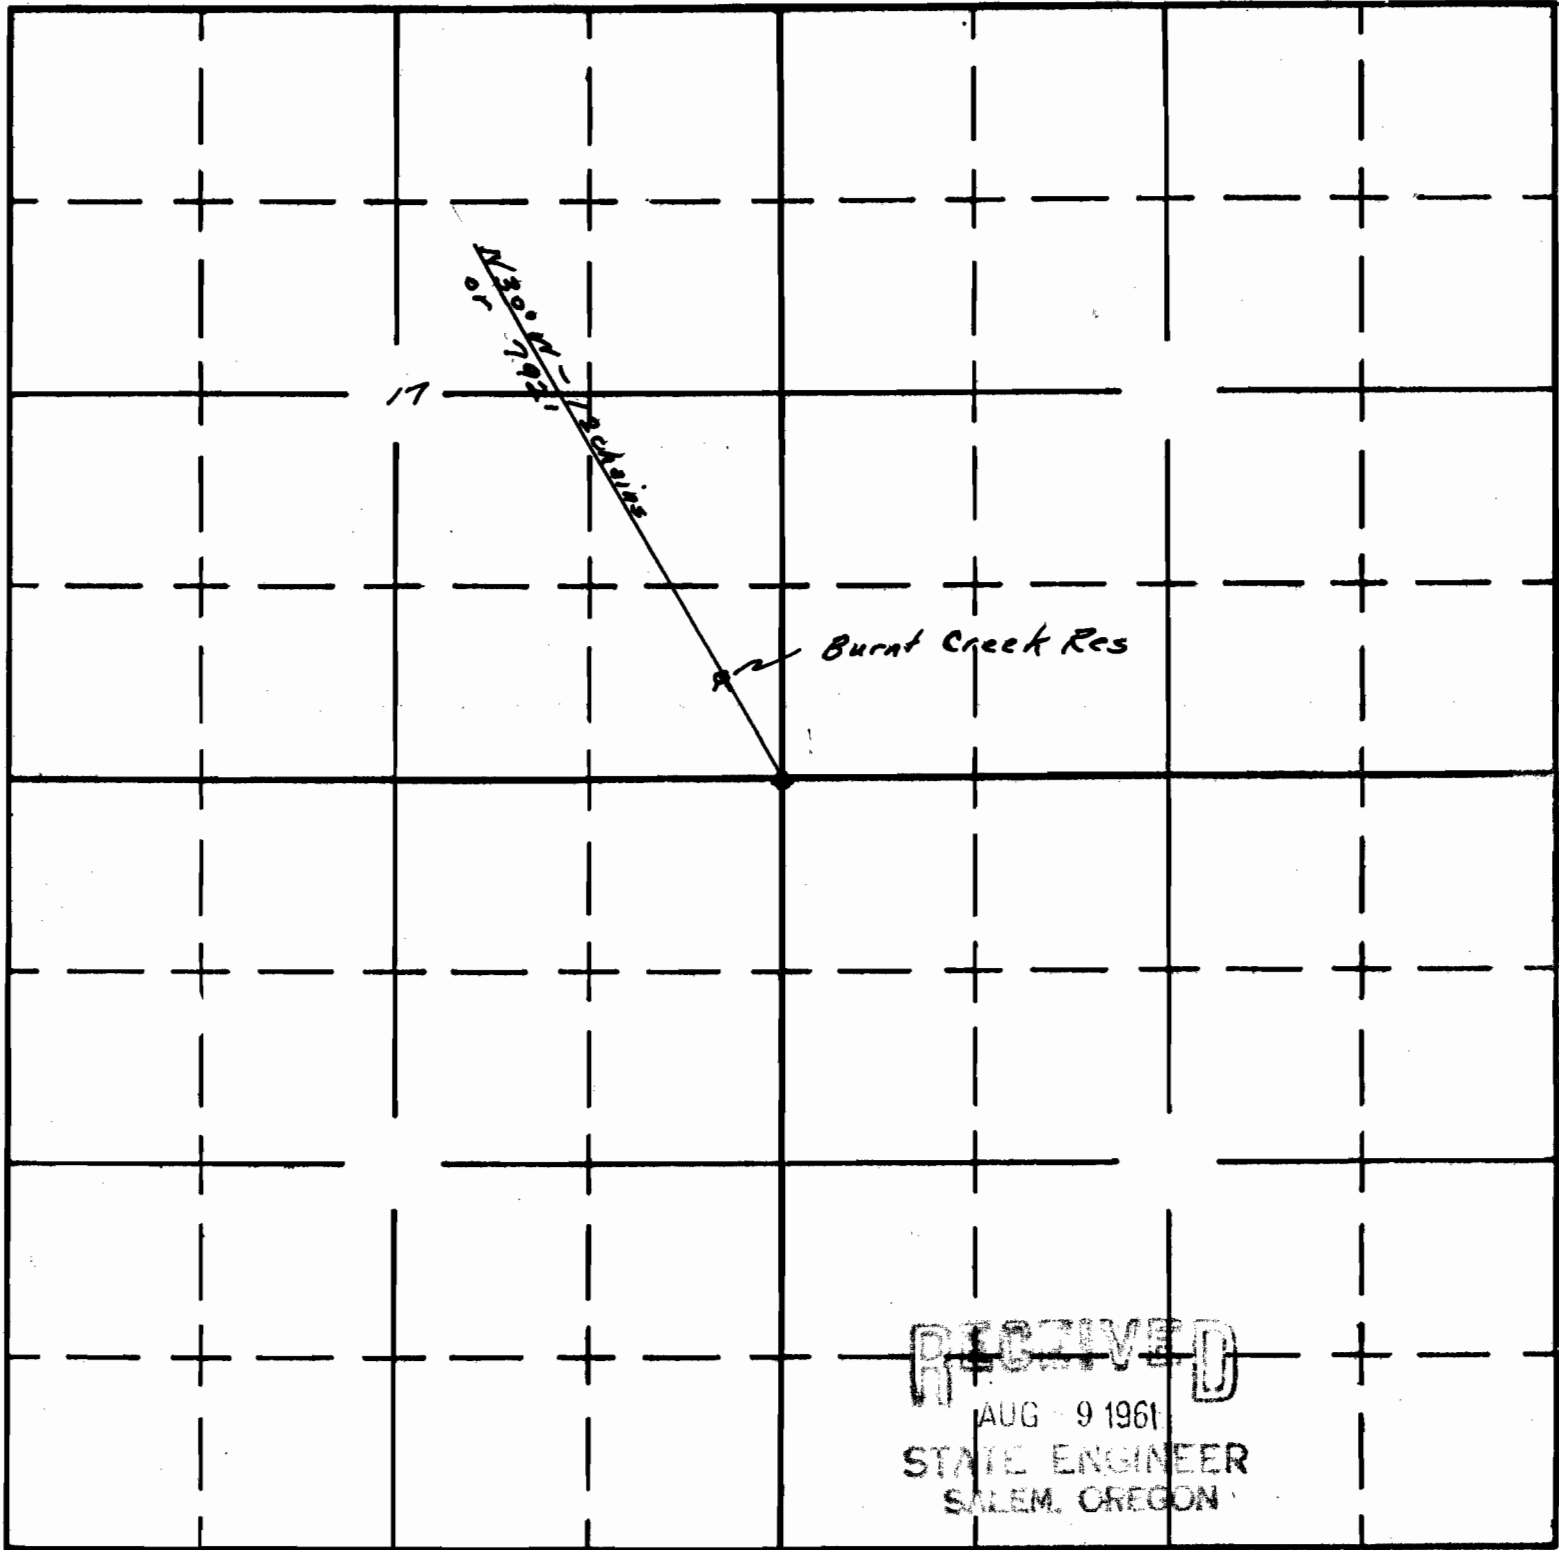

RECEIVED

AUG - 9 1961

STATE ENGINEER
SALEM, OREGON

APPLICATION No. *R-36990*

PERMIT No. *R-3243*