


Form AI-187
March 1961

UNITED STATES
DEPARTMENT OF THE INTERIOR
BUREAU OF LAND MANAGEMENT

SECTION
SE 1/4 SE 1/4
SEC. 29

Oregon State Water Filings

TOWNSHIP 30 S, RANGE 32 E, W. M.

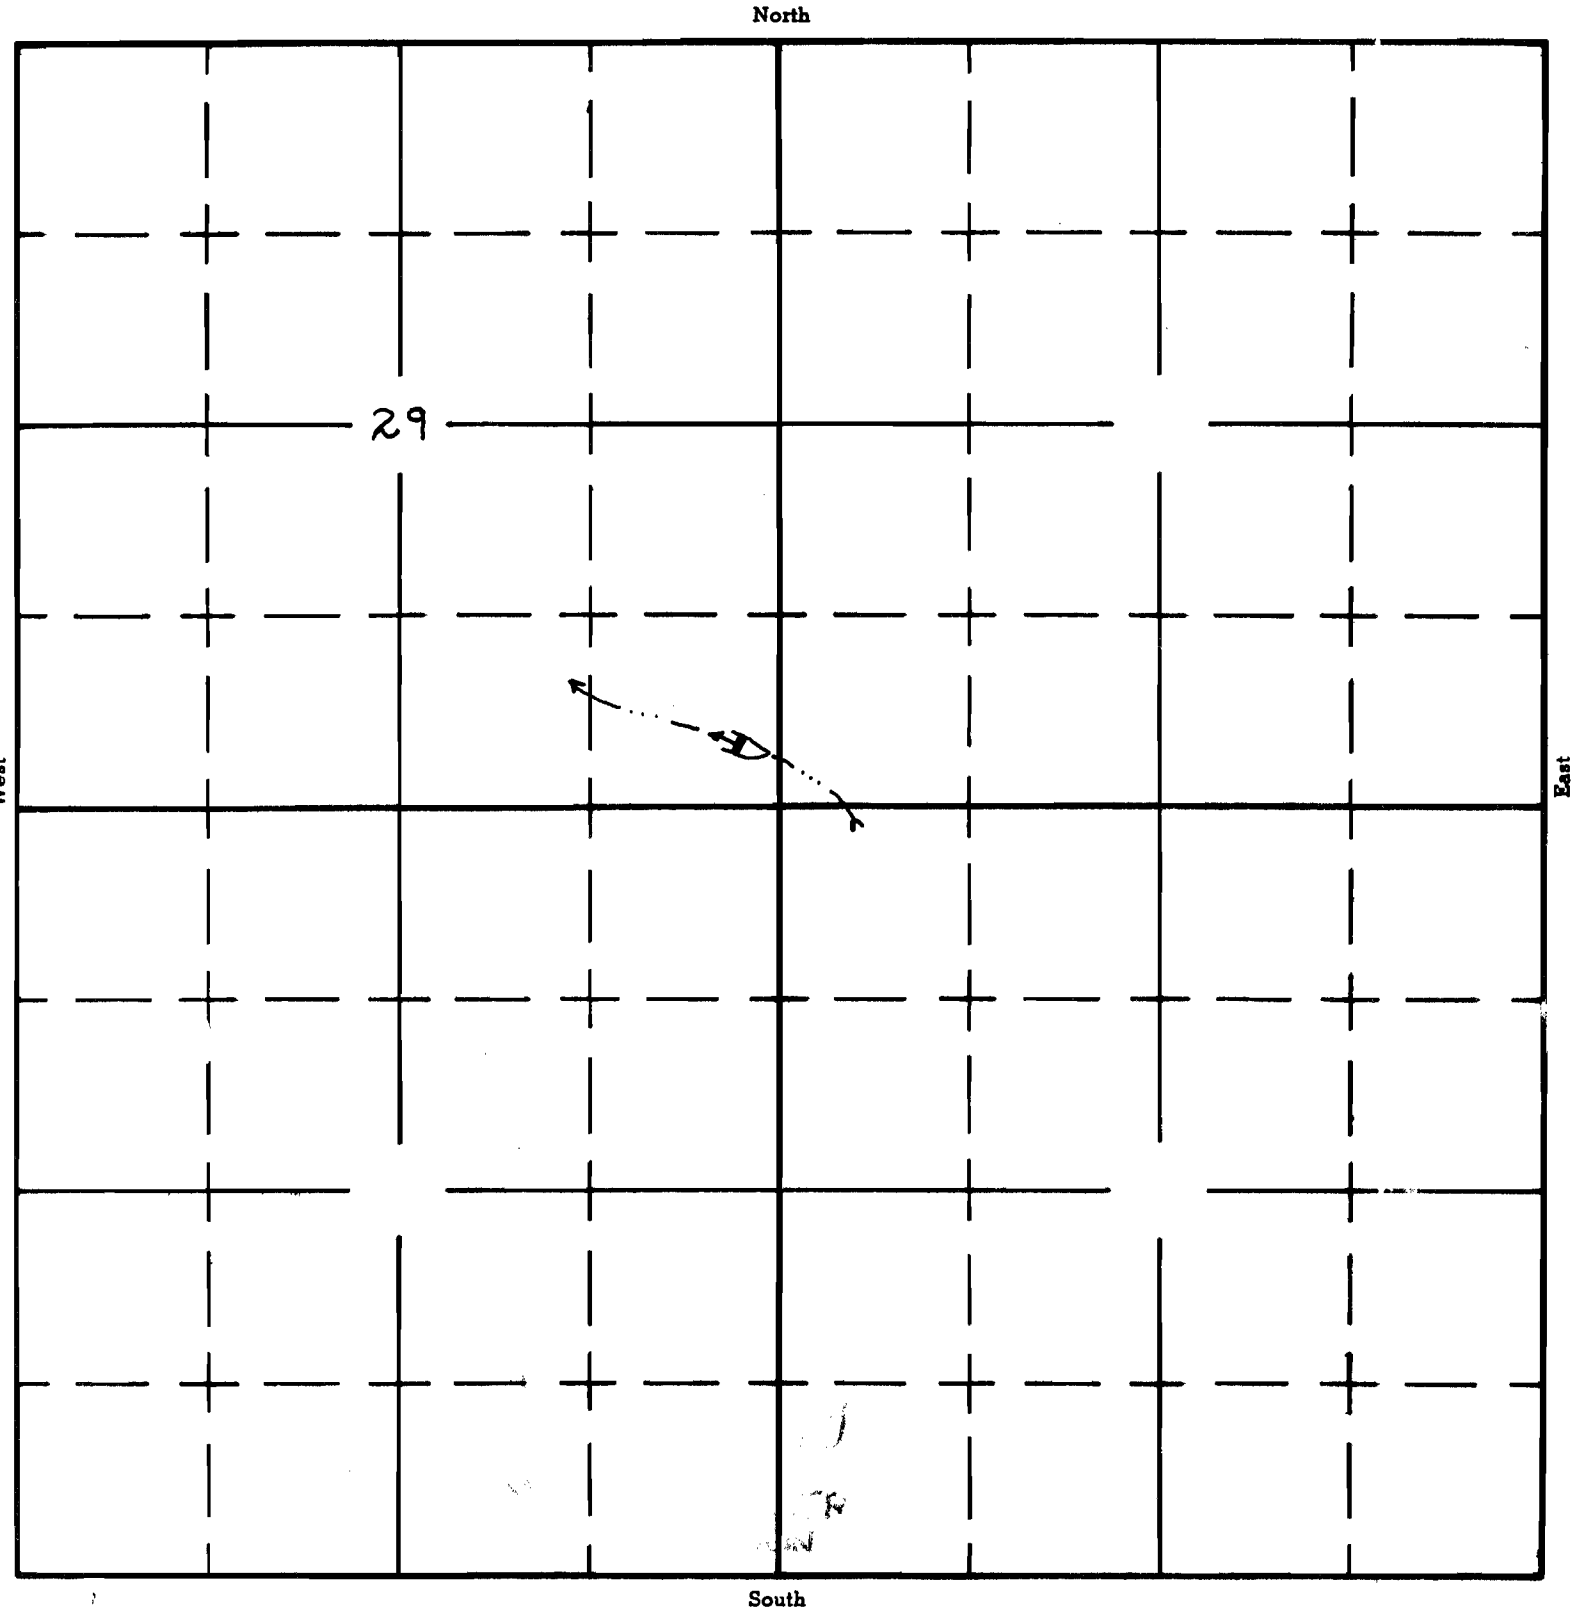

APPLICATION No. R-35344
PERMIT No. R-3349