

Form AI-187
March 1961

UNITED STATES
DEPARTMENT OF THE INTERIOR
BUREAU OF LAND MANAGEMENT

SECTION


NE $\frac{1}{4}$ NE $\frac{1}{4}$

SEC 17

Oregon State Water Filings

TOWNSHIP 24 S, RANGE 28 E, W. M.

North

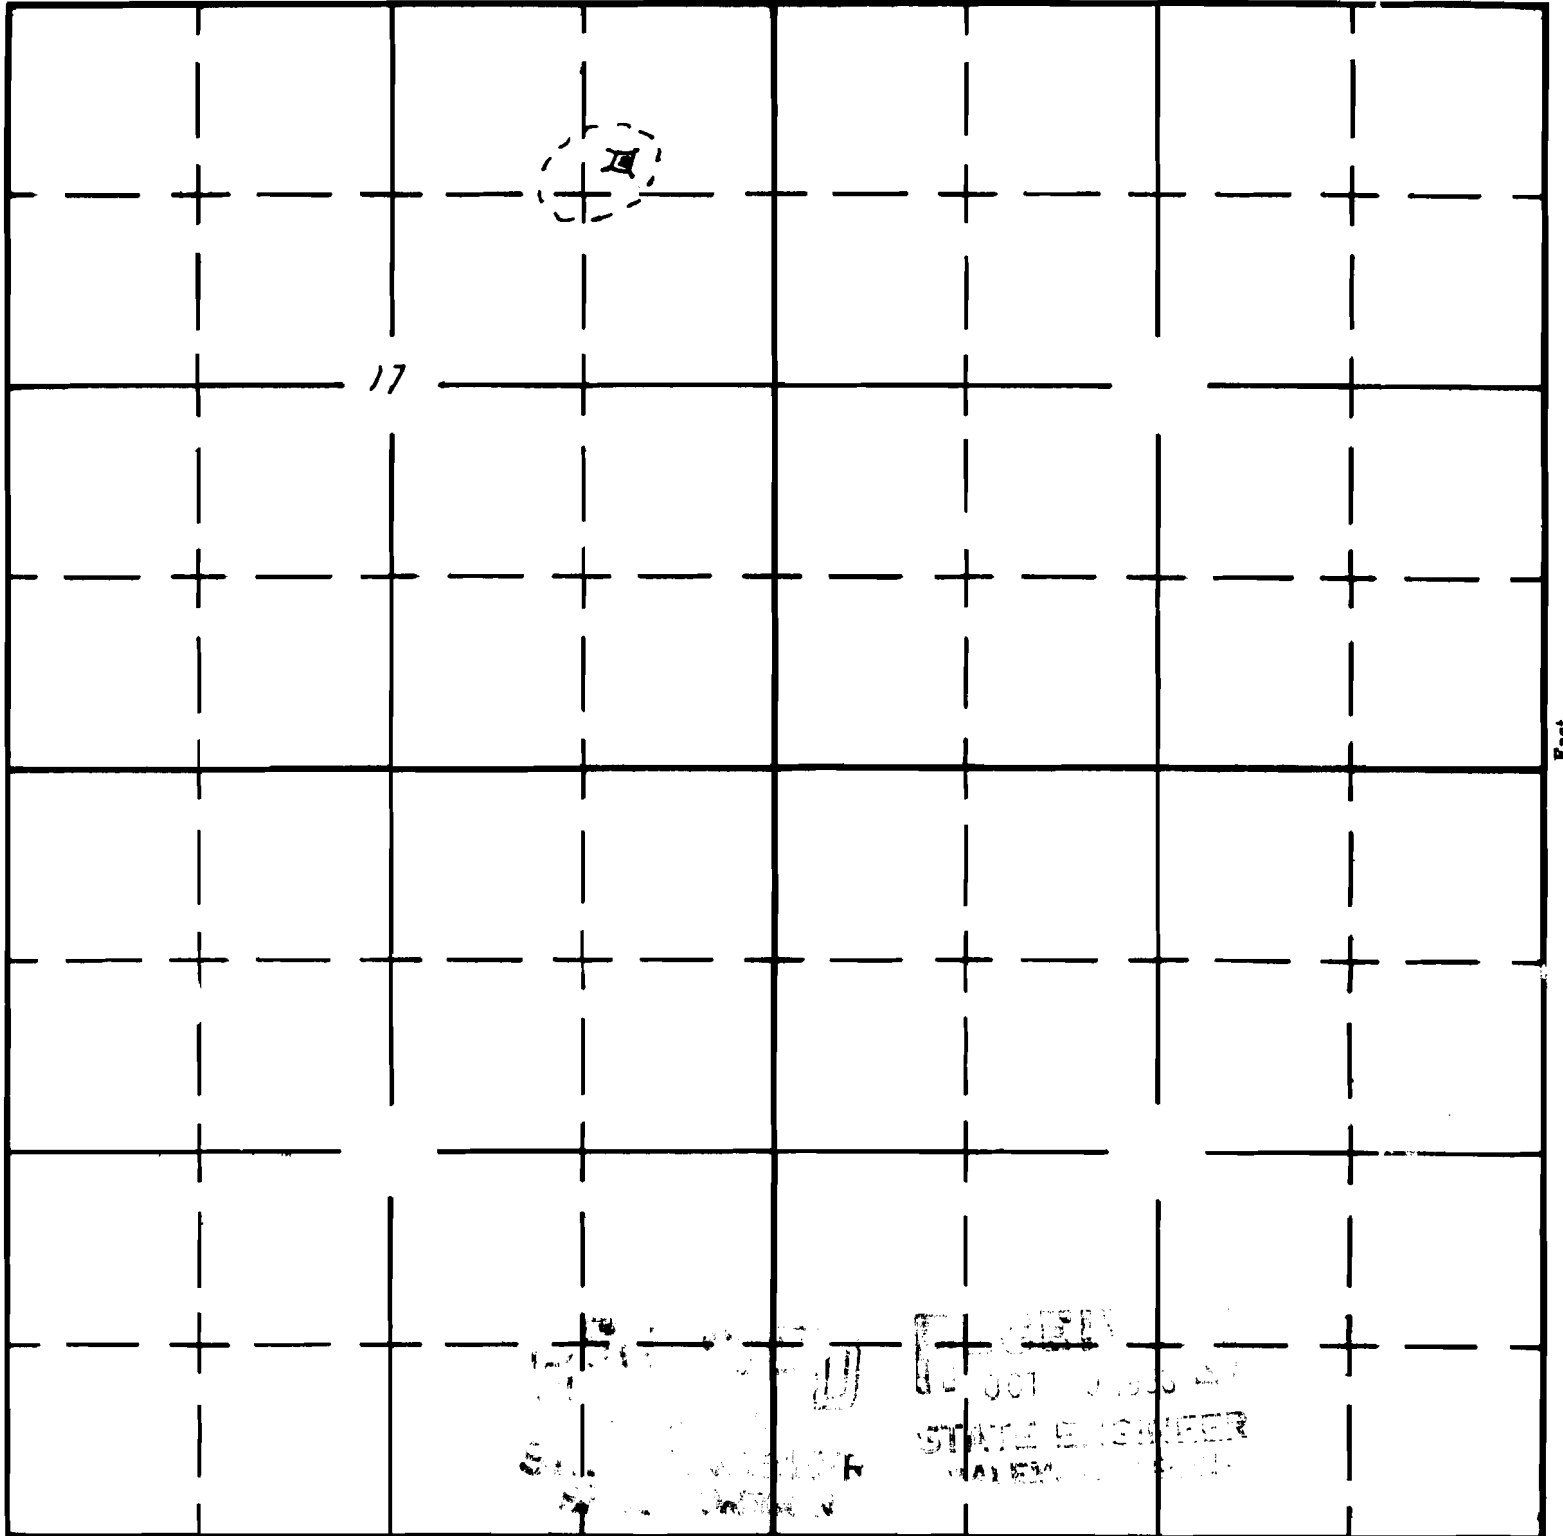

South

APPLICATION No. R-35861
PERMIT No. R-3434