

Form AI-187
March 1961

UNITED STATES
DEPARTMENT OF THE INTERIOR
BUREAU OF LAND MANAGEMENT

SECTION


SW $\frac{1}{4}$ NE $\frac{1}{4}$

Oregon State Water Filings

SEC. 4

TOWNSHIP 26S, RANGE 23E, W. M.

North

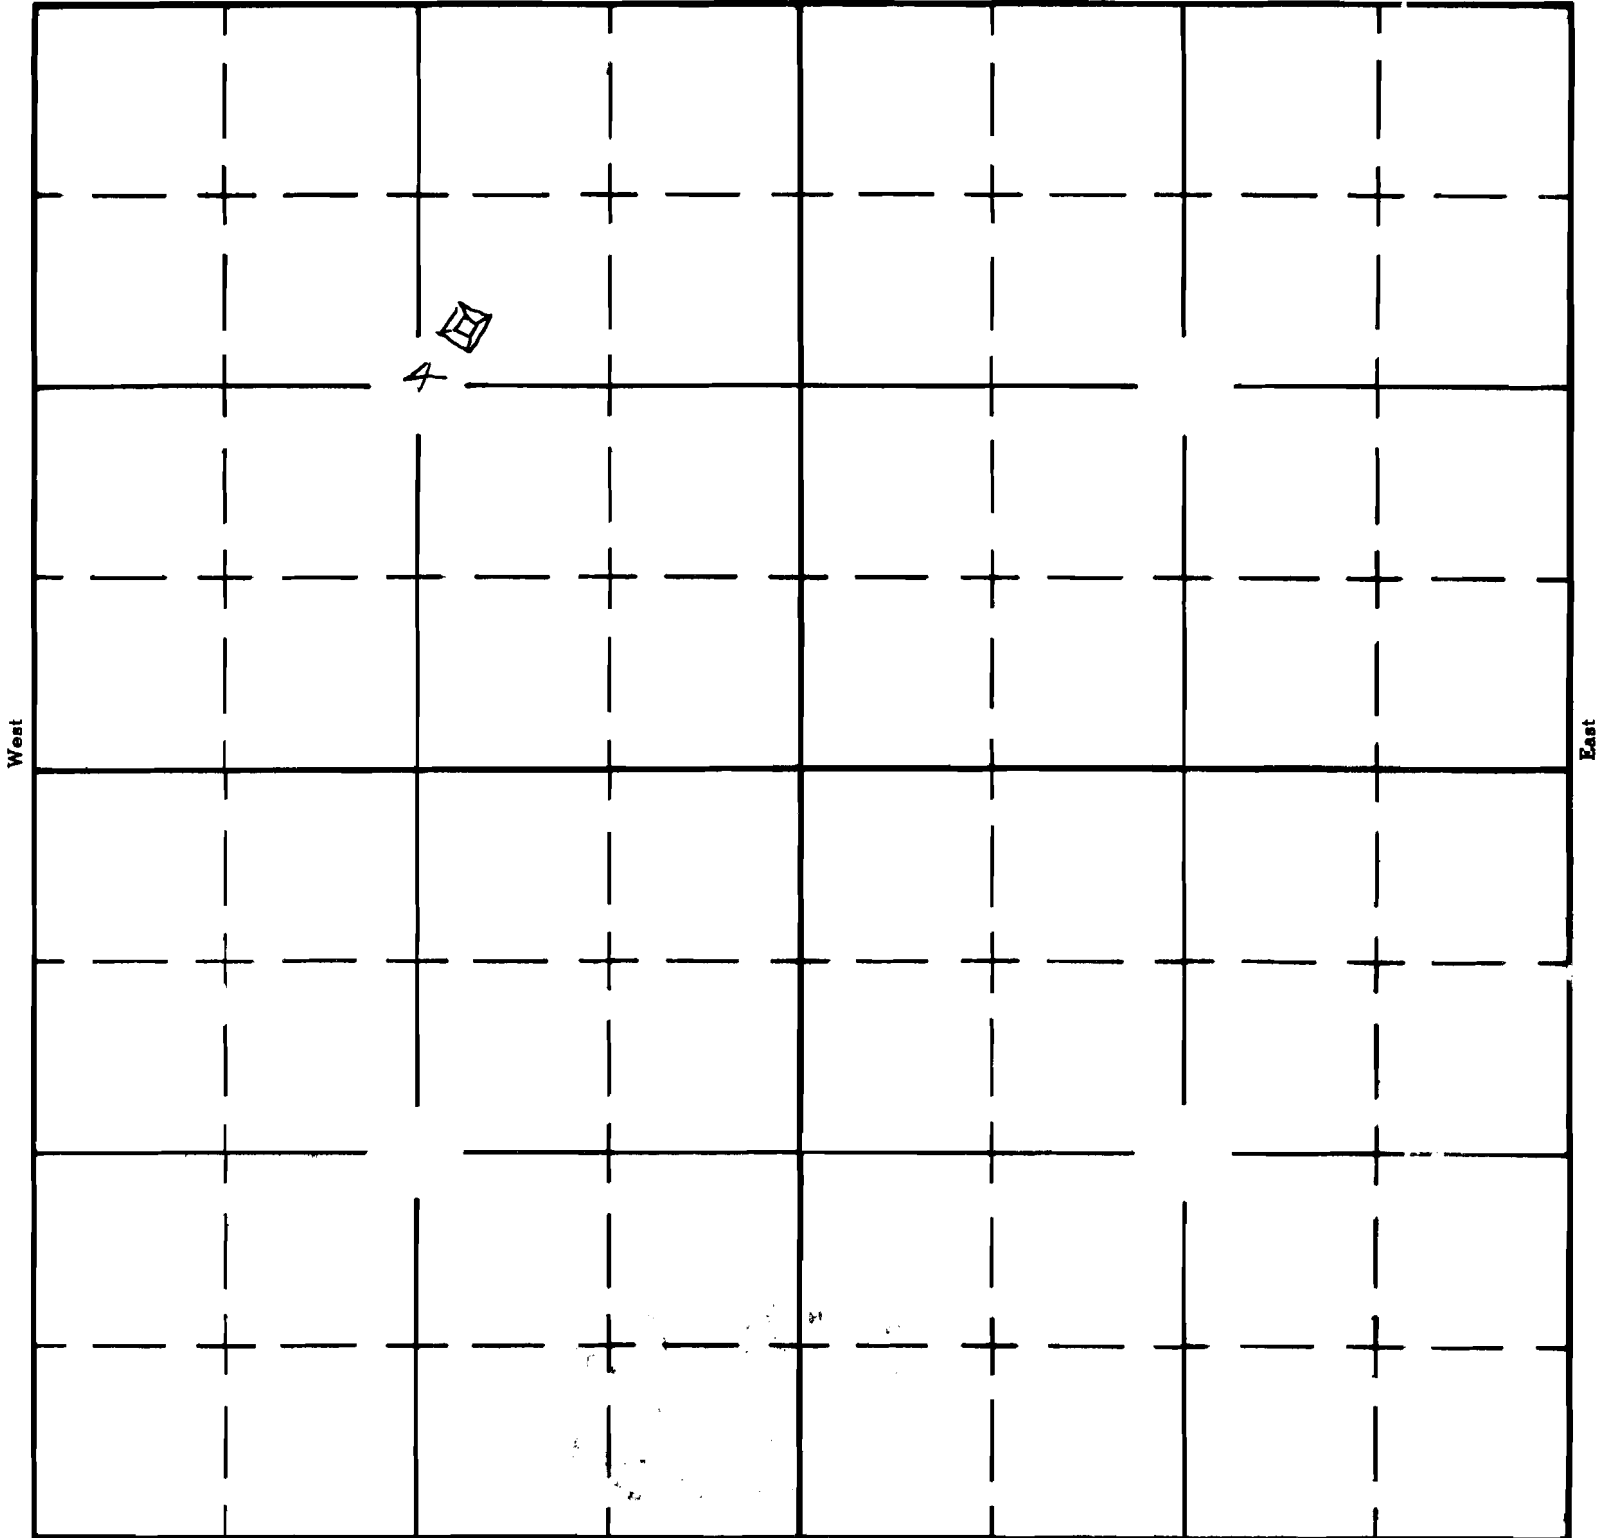

South

APPLICATION No. R-35880
PERMIT No. R-3436