
Form A1-187
March 1961

UNITED STATES
DEPARTMENT OF THE INTERIOR
BUREAU OF LAND MANAGEMENT

SECTION NW¼ NE¼
SEC 12

Oregon State Water Filings

TOWNSHIP 27S, RANGE 23E, W. M.

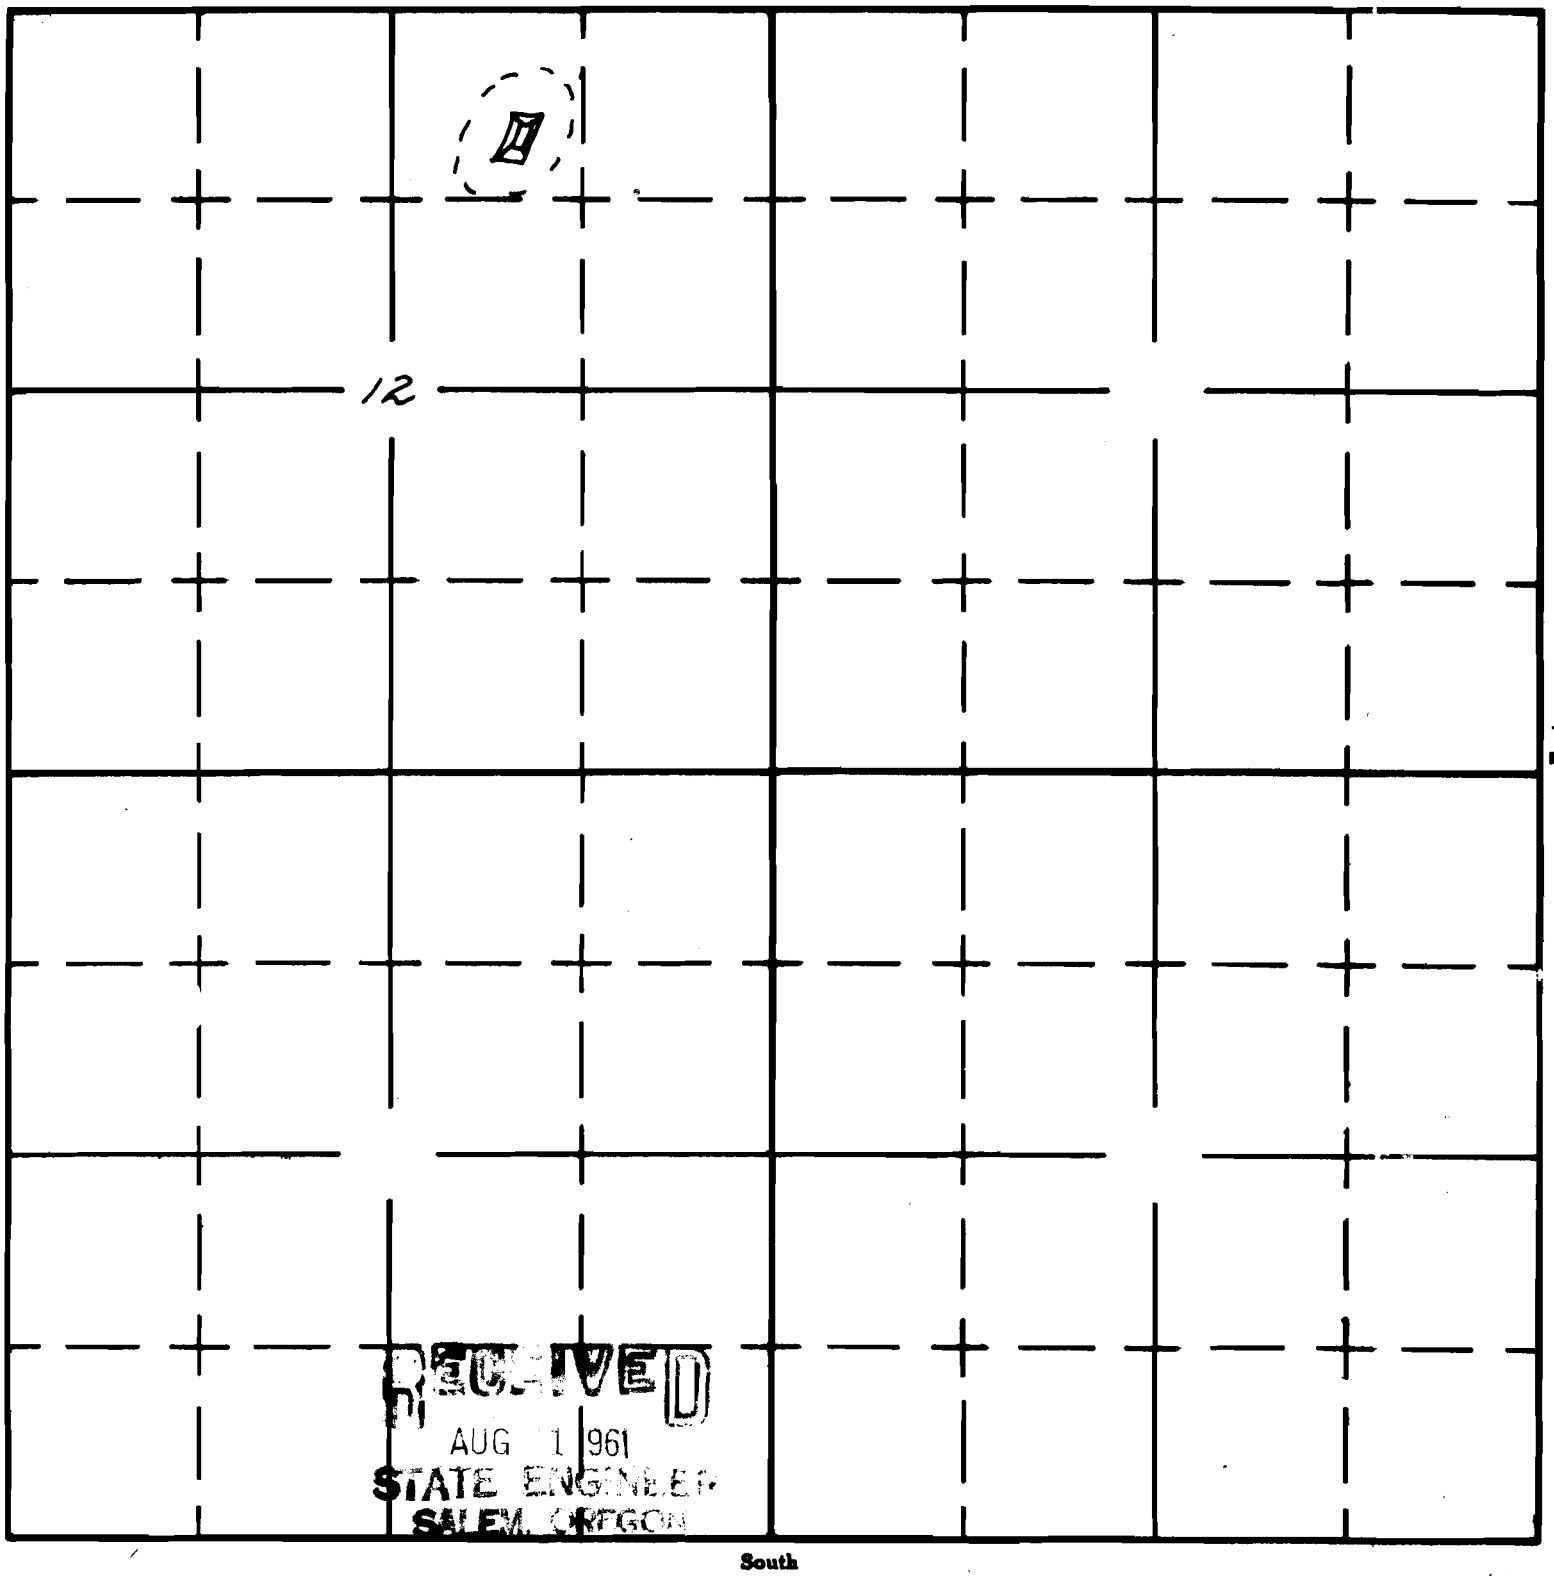

RECEIVED
AUG 1 1961
STATE ENGINEER
SALEM, OREGON

APPLICATION No. R-35881
PERMIT No. R-3437