

Form AI-187
March 1961

UNITED STATES
DEPARTMENT OF THE INTERIOR
BUREAU OF LAND MANAGEMENT

SECTION

NE $\frac{1}{4}$ SW $\frac{1}{4}$

Oregon State Water Filings


SEC 21

TOWNSHIP 24S, RANGE 26E, W. M.

North

West

East

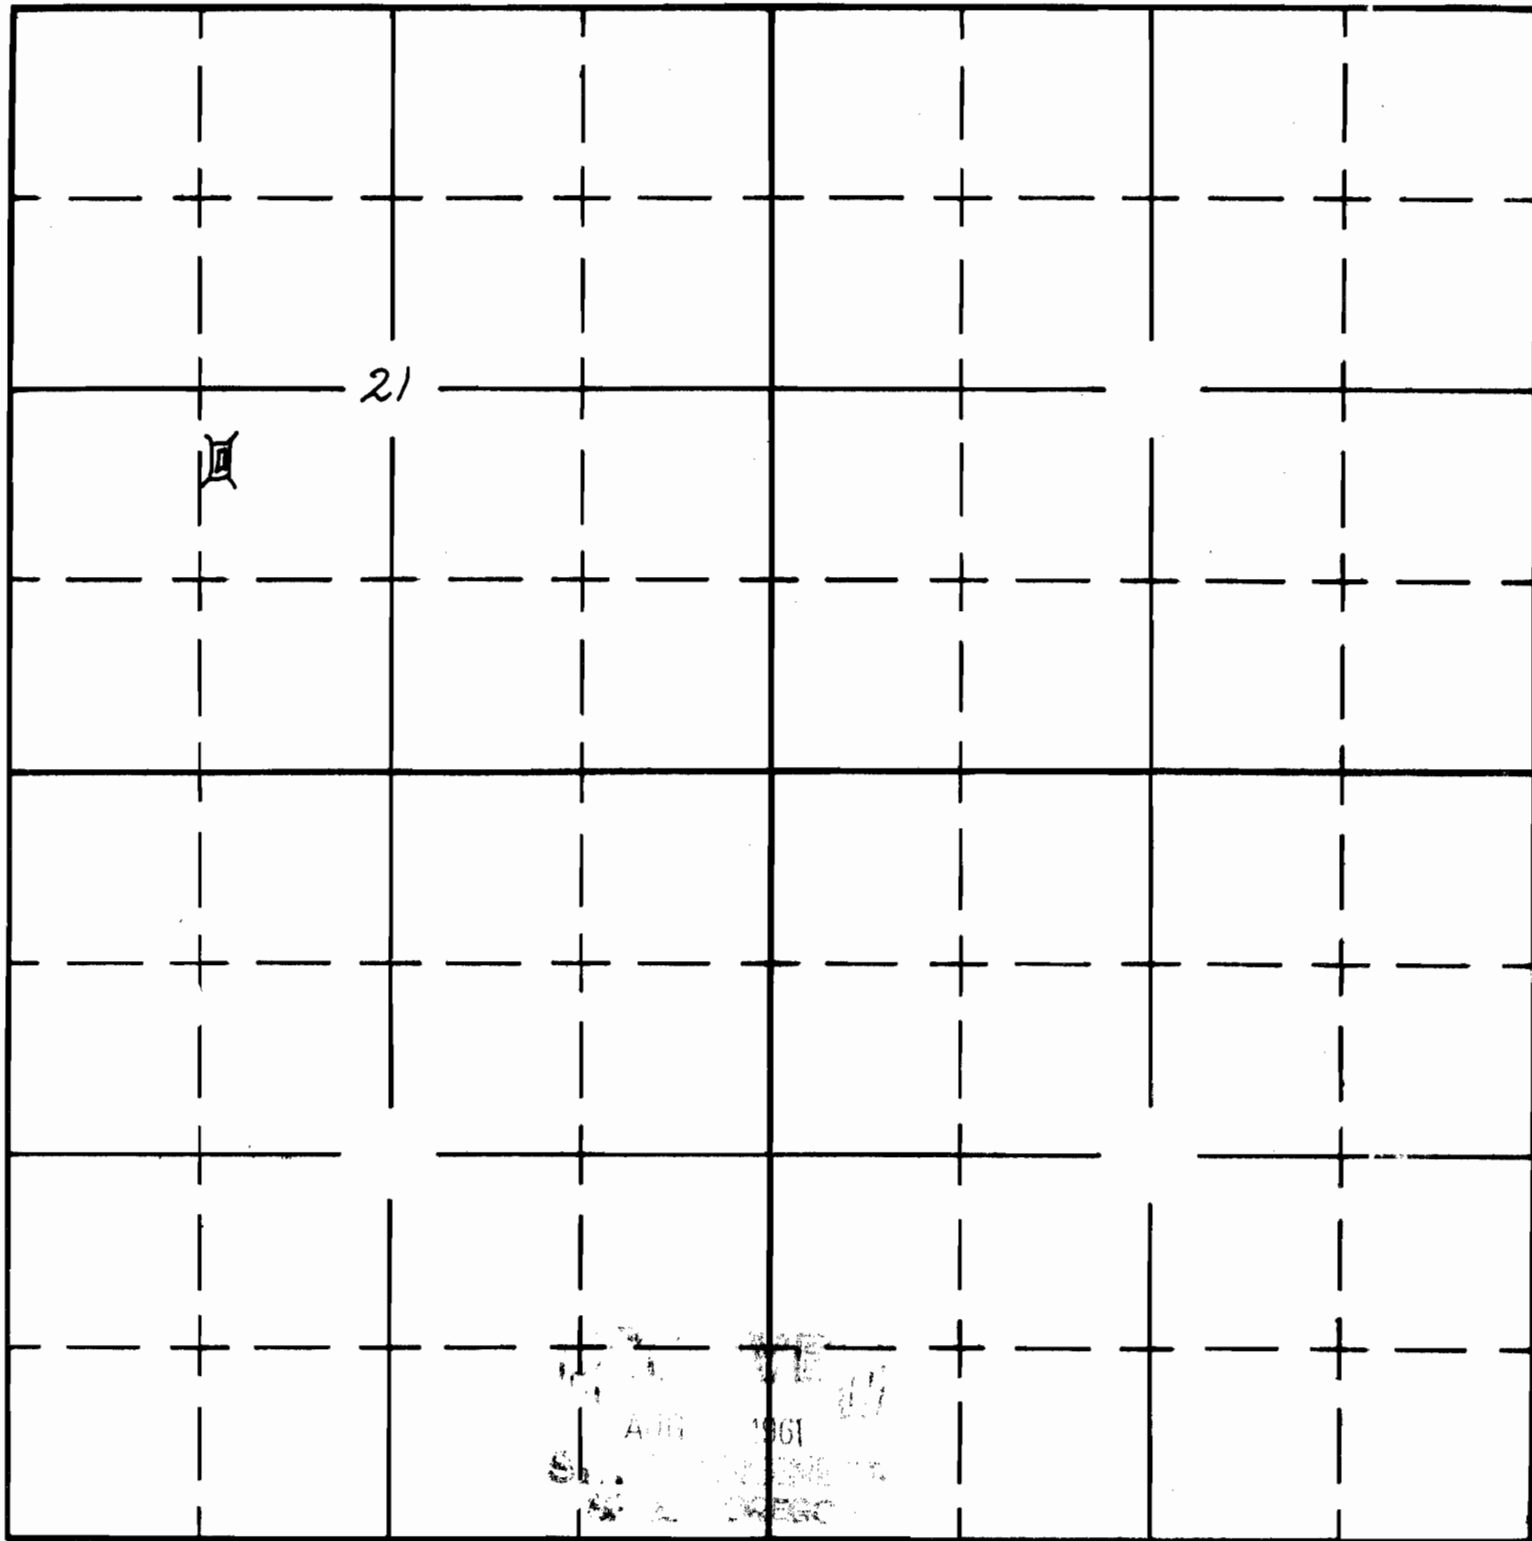

South

APPLICATION No. R-35908
PERMIT No. R-3449