

UNITED STATES
DEPARTMENT OF THE INTERIOR
BUREAU OF LAND MANAGEMENT

SECTION


Oregon State Water Filings

SE 1/4 SE 1/4

TOWNSHIP 30s, RANGE 29 1/4 W. M.

Sec 14

North

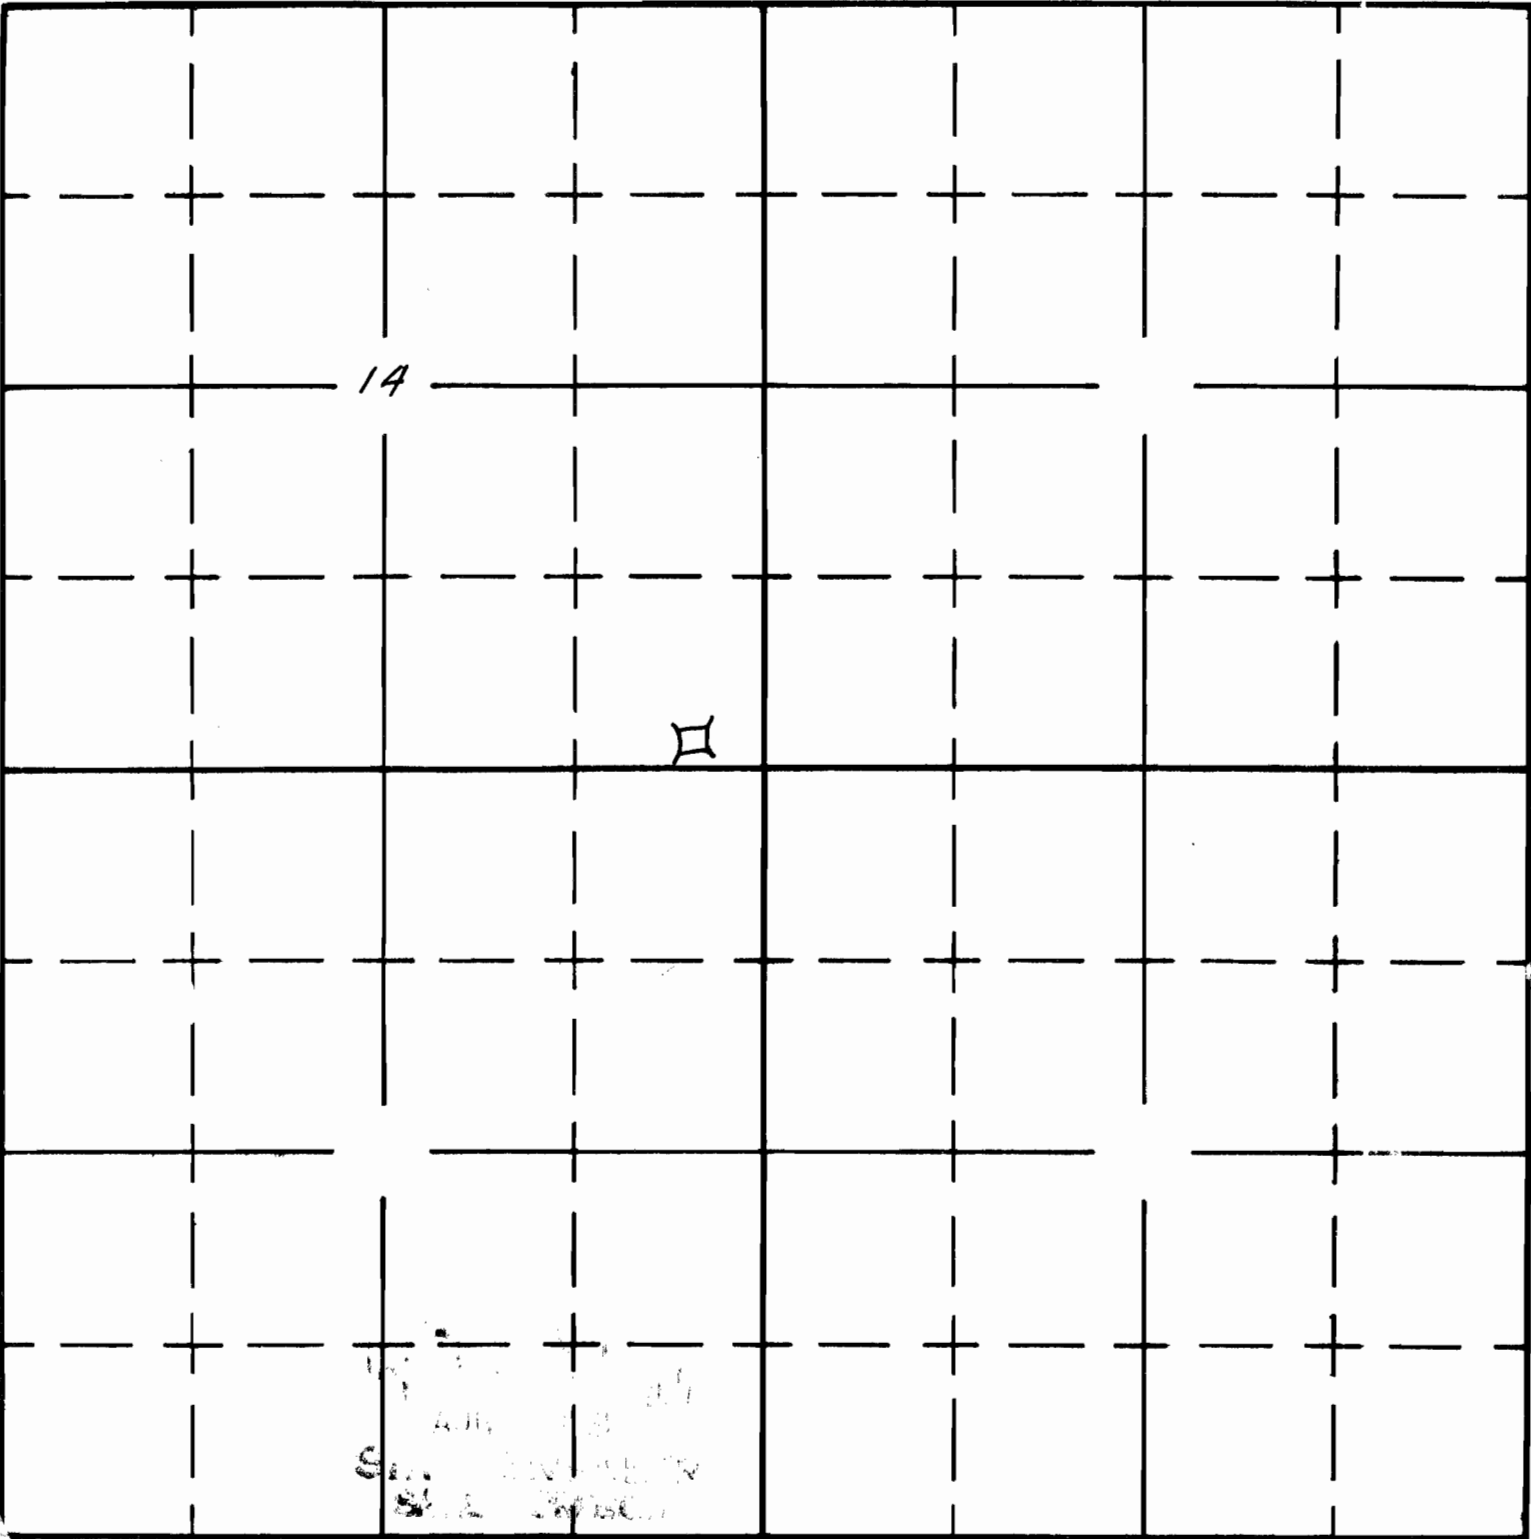

South