

Form AI-187
March 1961


UNITED STATES
DEPARTMENT OF THE INTERIOR
BUREAU OF LAND MANAGEMENT

Oregon State Water Filings

SECTION _____

TOWNSHIP 22S, RANGE 44E, W. M.

North

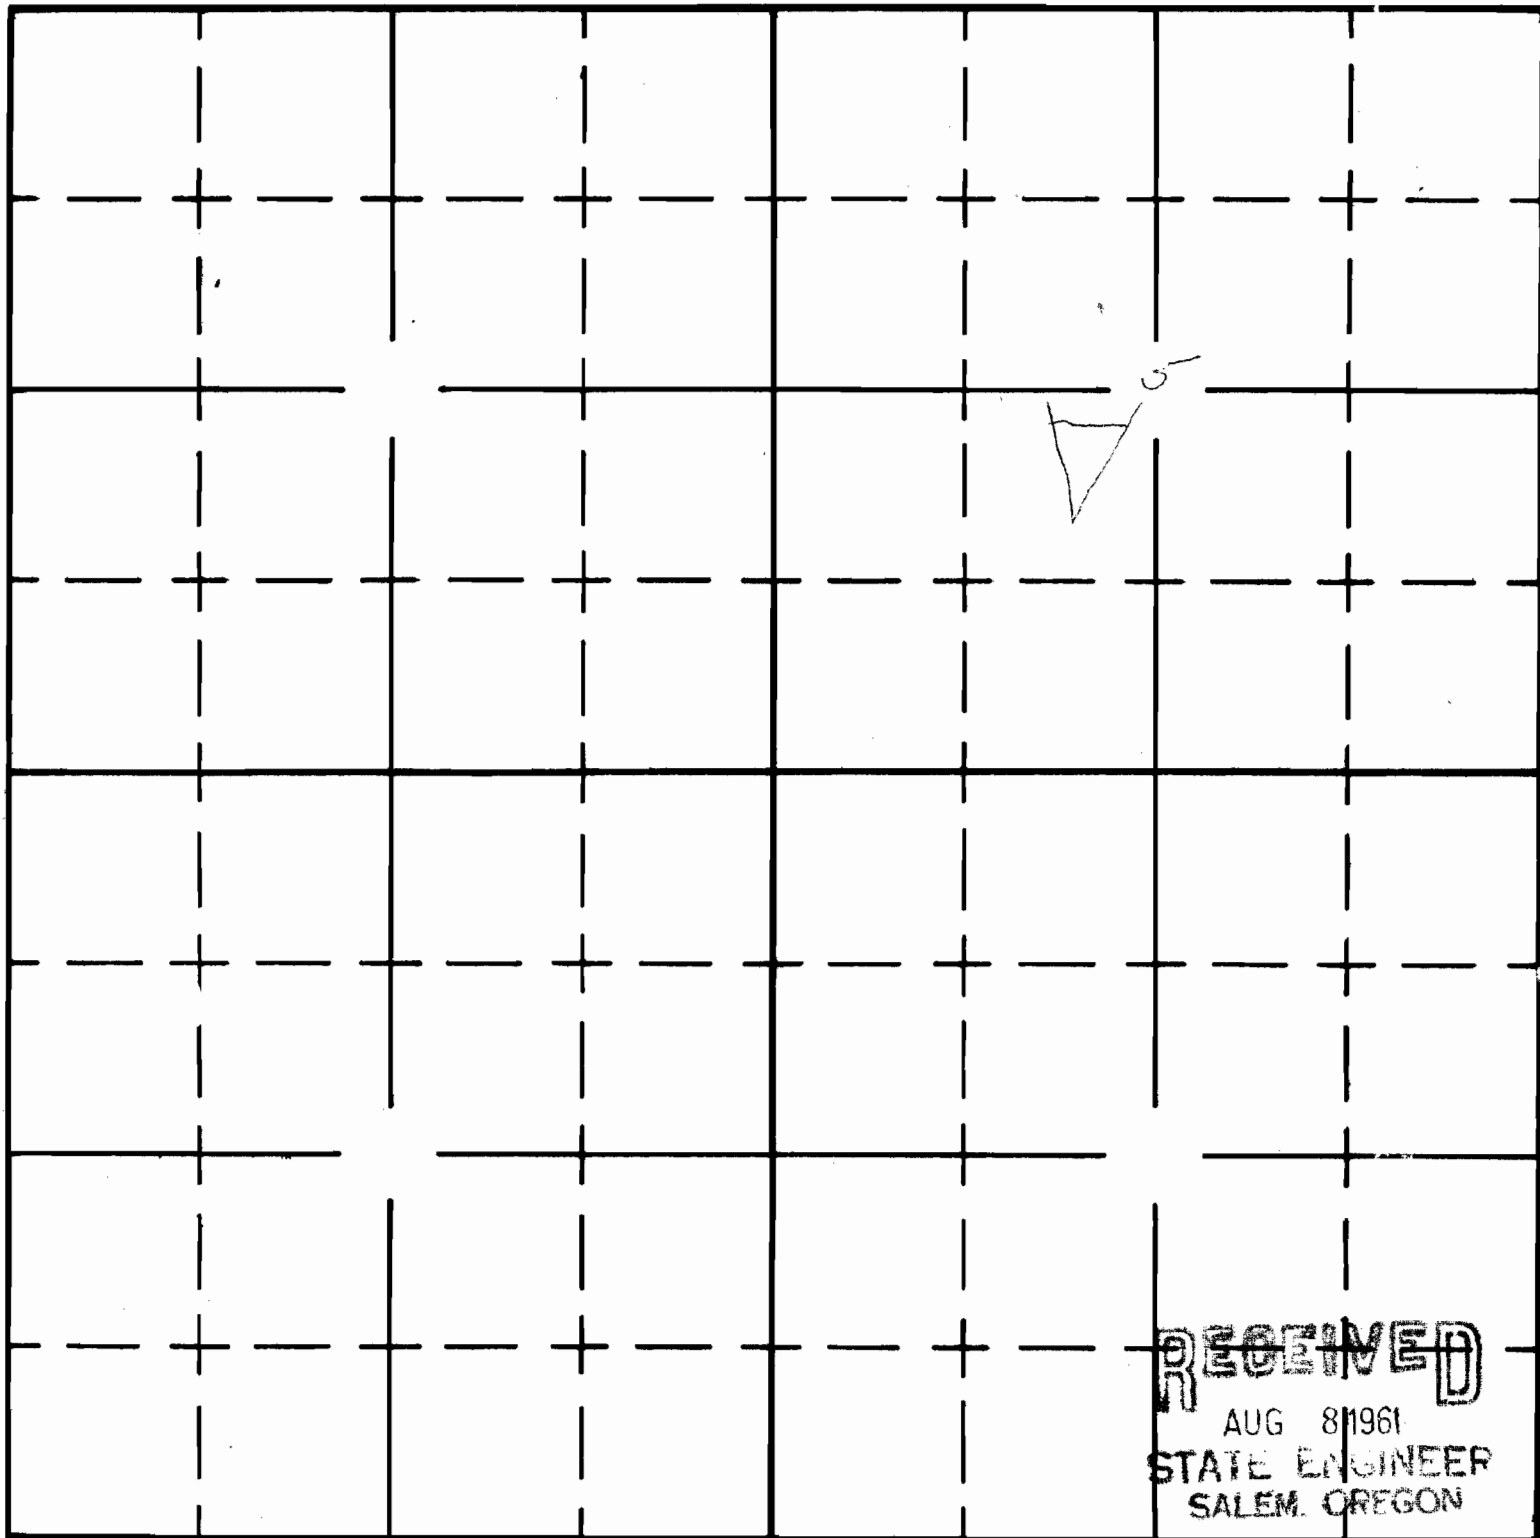

South

RECEIVED
AUG 8 1961
STATE ENGINEER
SALEM, OREGON

APPLICATION No. R-36869
PERMIT No. R-3464