

Form A1-187
March 1961

UNITED STATES
DEPARTMENT OF THE INTERIOR
BUREAU OF LAND MANAGEMENT

SECTION


Oregon State Water Filings

NW 1/4 NE 1/4

TOWNSHIP 26S, RANGE 23E, W. M.

Sec 15

North

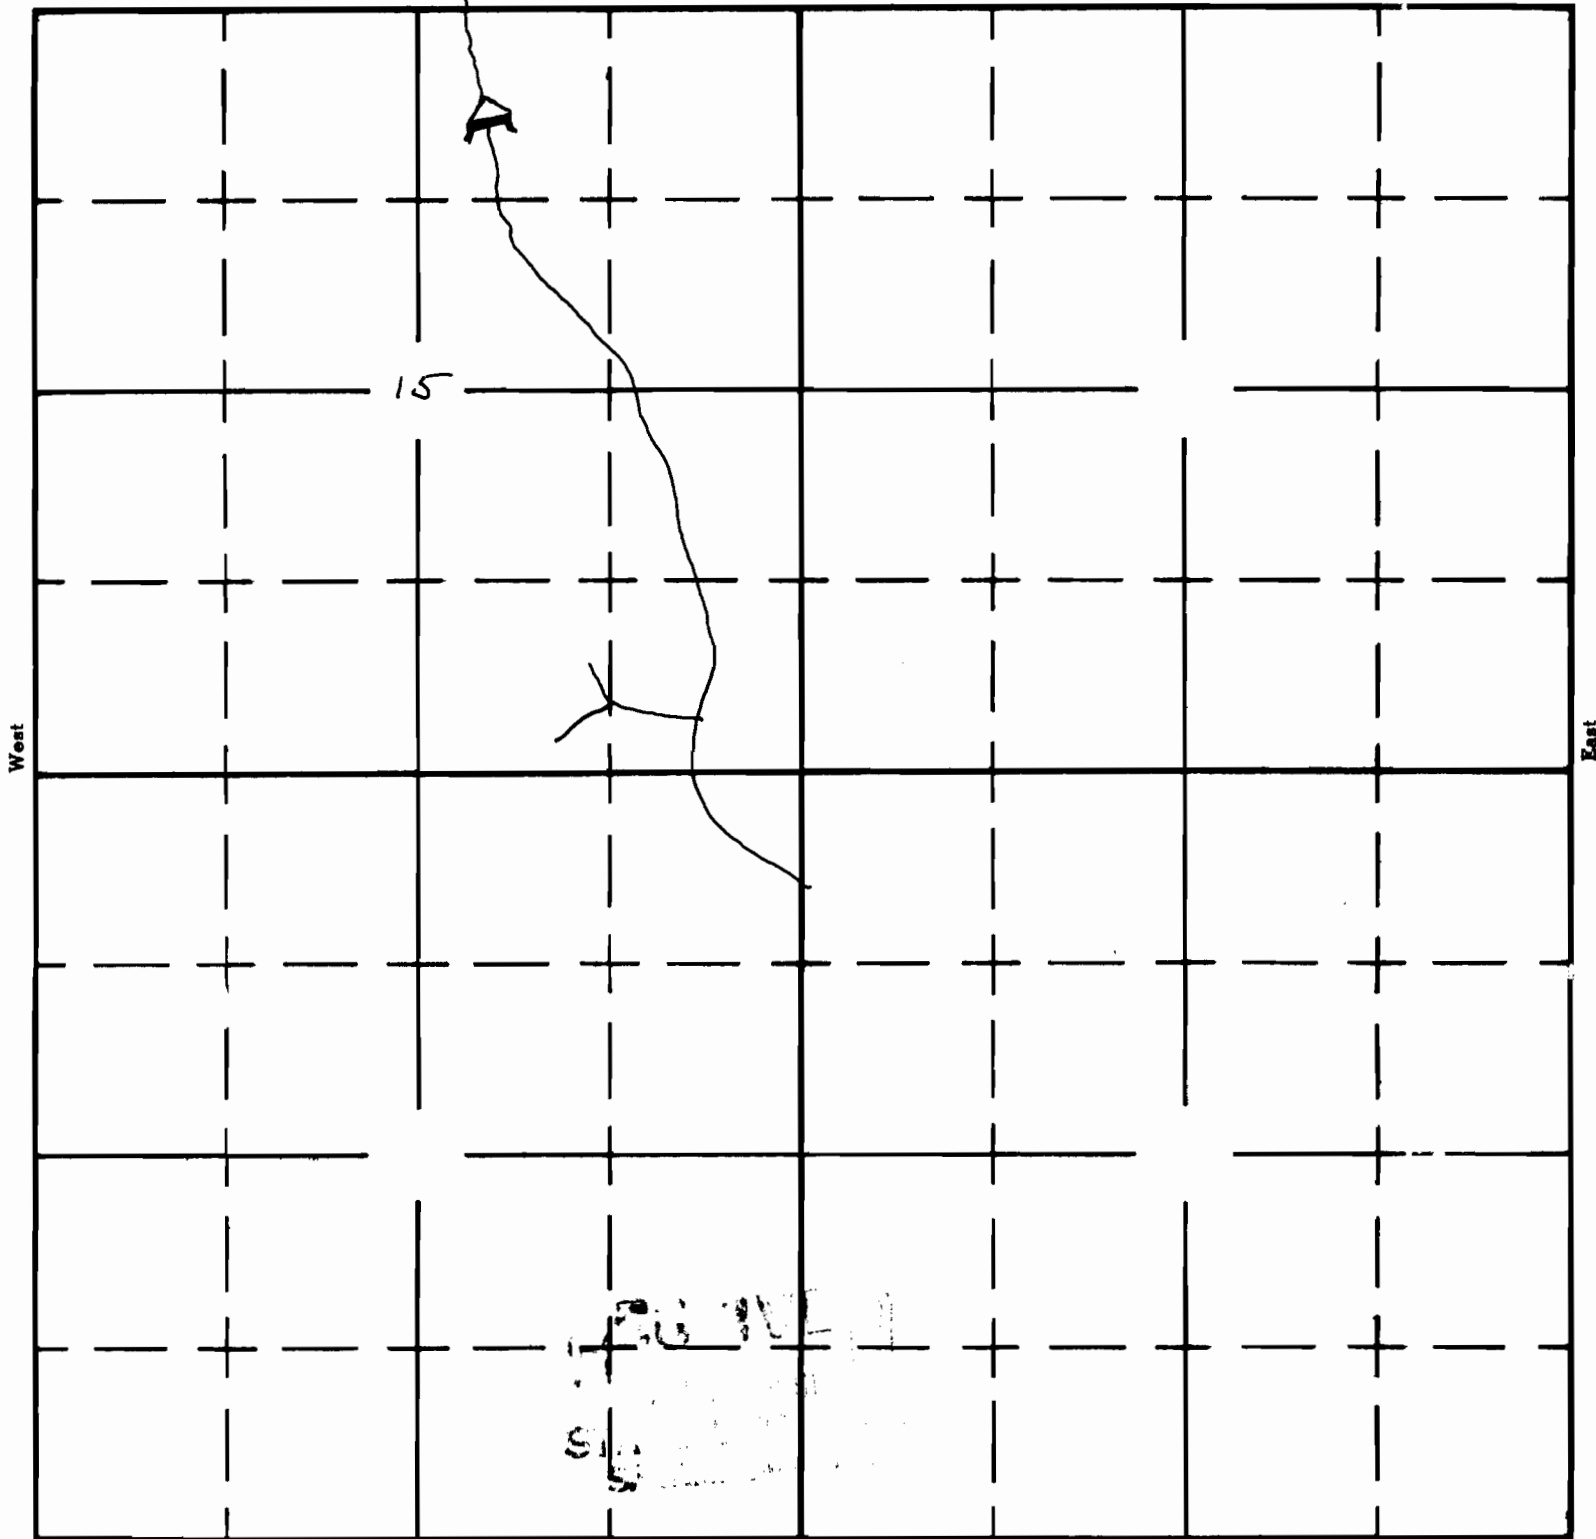

South

APPLICATION No. R-35832

PERMIT No. R-3480