

Form AI-187  
March 1961

UNITED STATES  
DEPARTMENT OF THE INTERIOR  
BUREAU OF LAND MANAGEMENT


SECTION  
NE  $\frac{1}{4}$  NE  $\frac{1}{4}$

# Oregon State Water Filings

SEC 35

TOWNSHIP 27S, RANGE 26E, W. M.

North

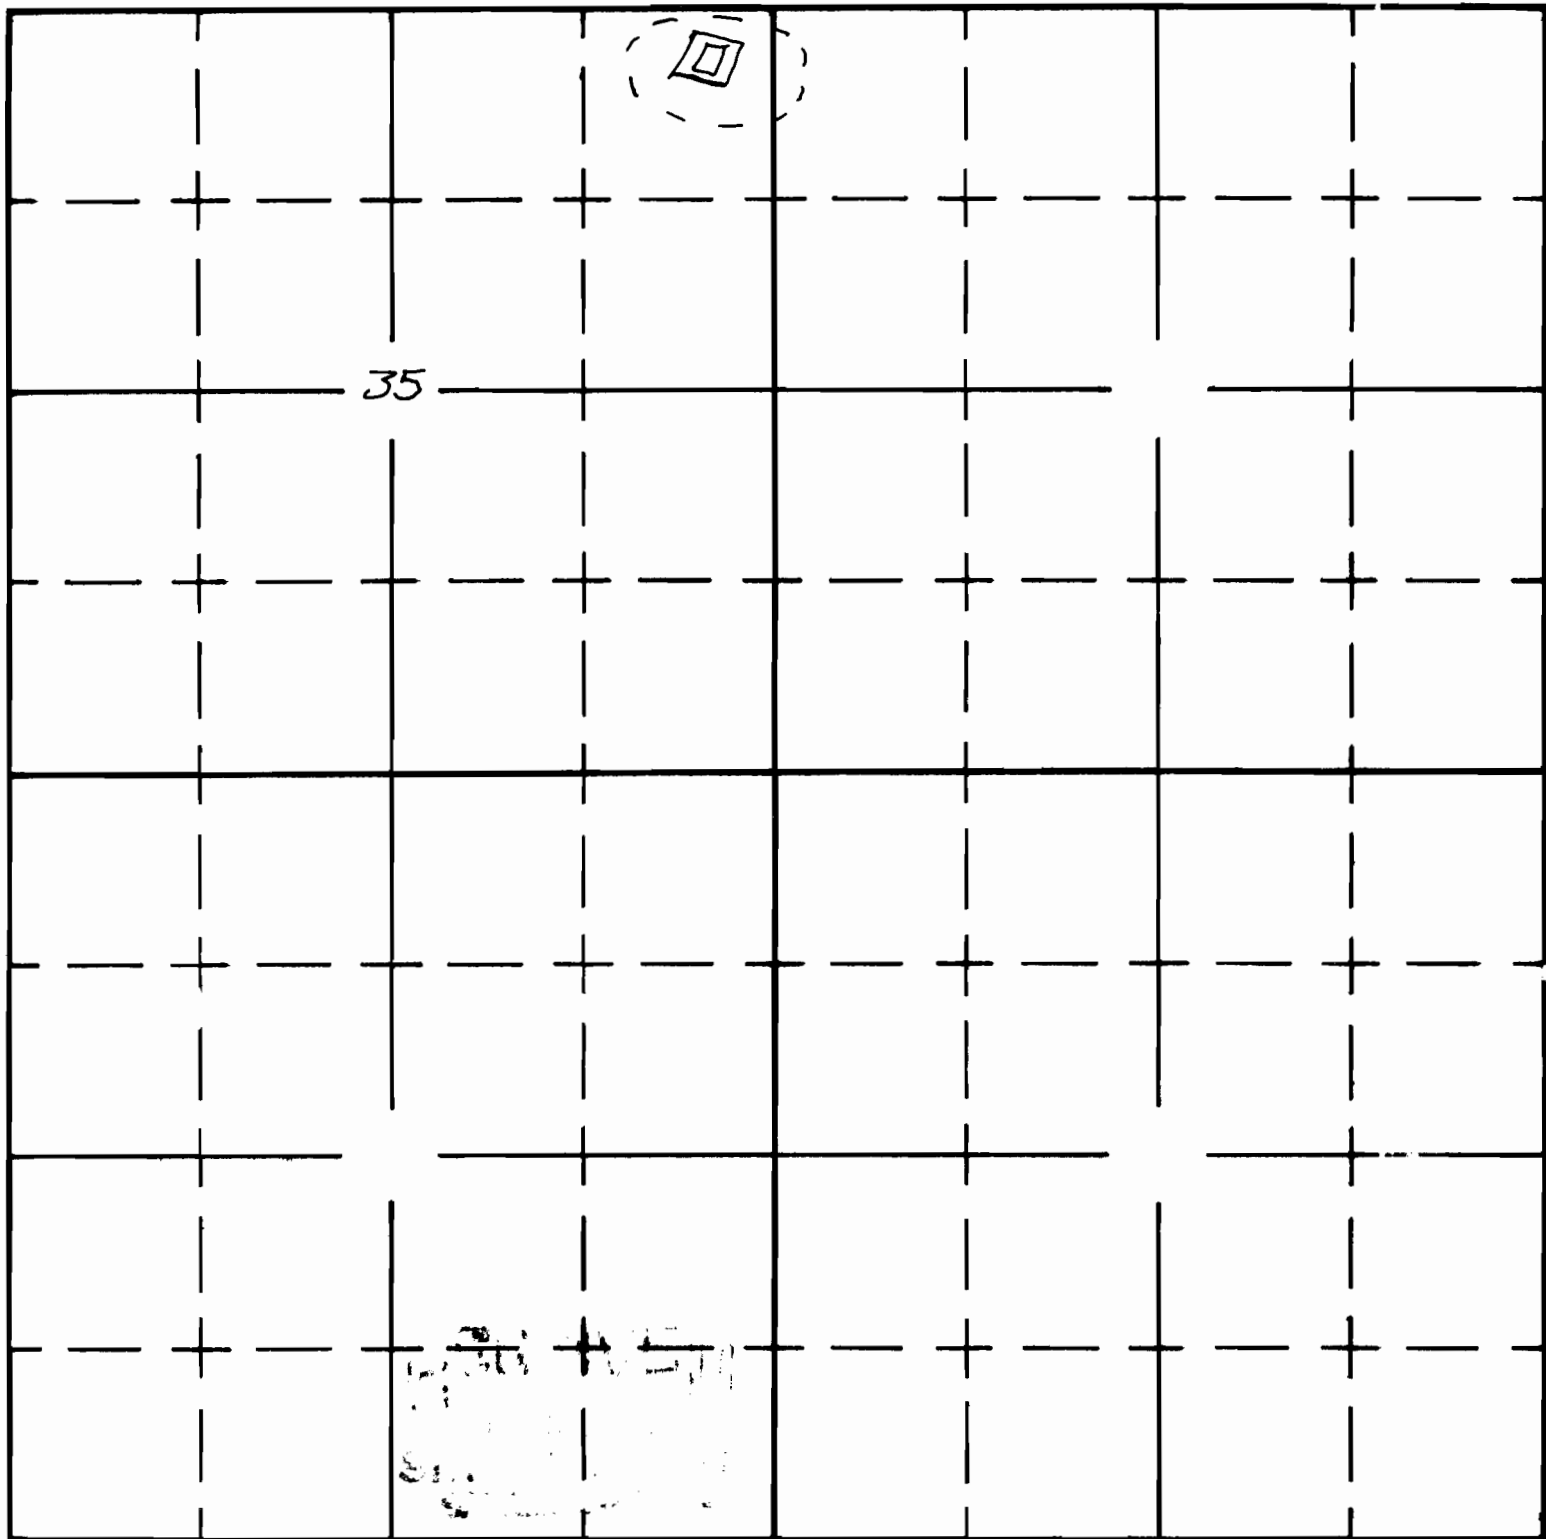

South

APPLICATION No. R-35836  
PERMIT No. R-3484