

Form AI-187
March 1961

UNITED STATES
DEPARTMENT OF THE INTERIOR
BUREAU OF LAND MANAGEMENT

SECTION


SE $\frac{1}{4}$ SW $\frac{1}{4}$

SEC 28

Oregon State Water Filings

TOWNSHIP 24 S, RANGE 29 E, W. M.

North

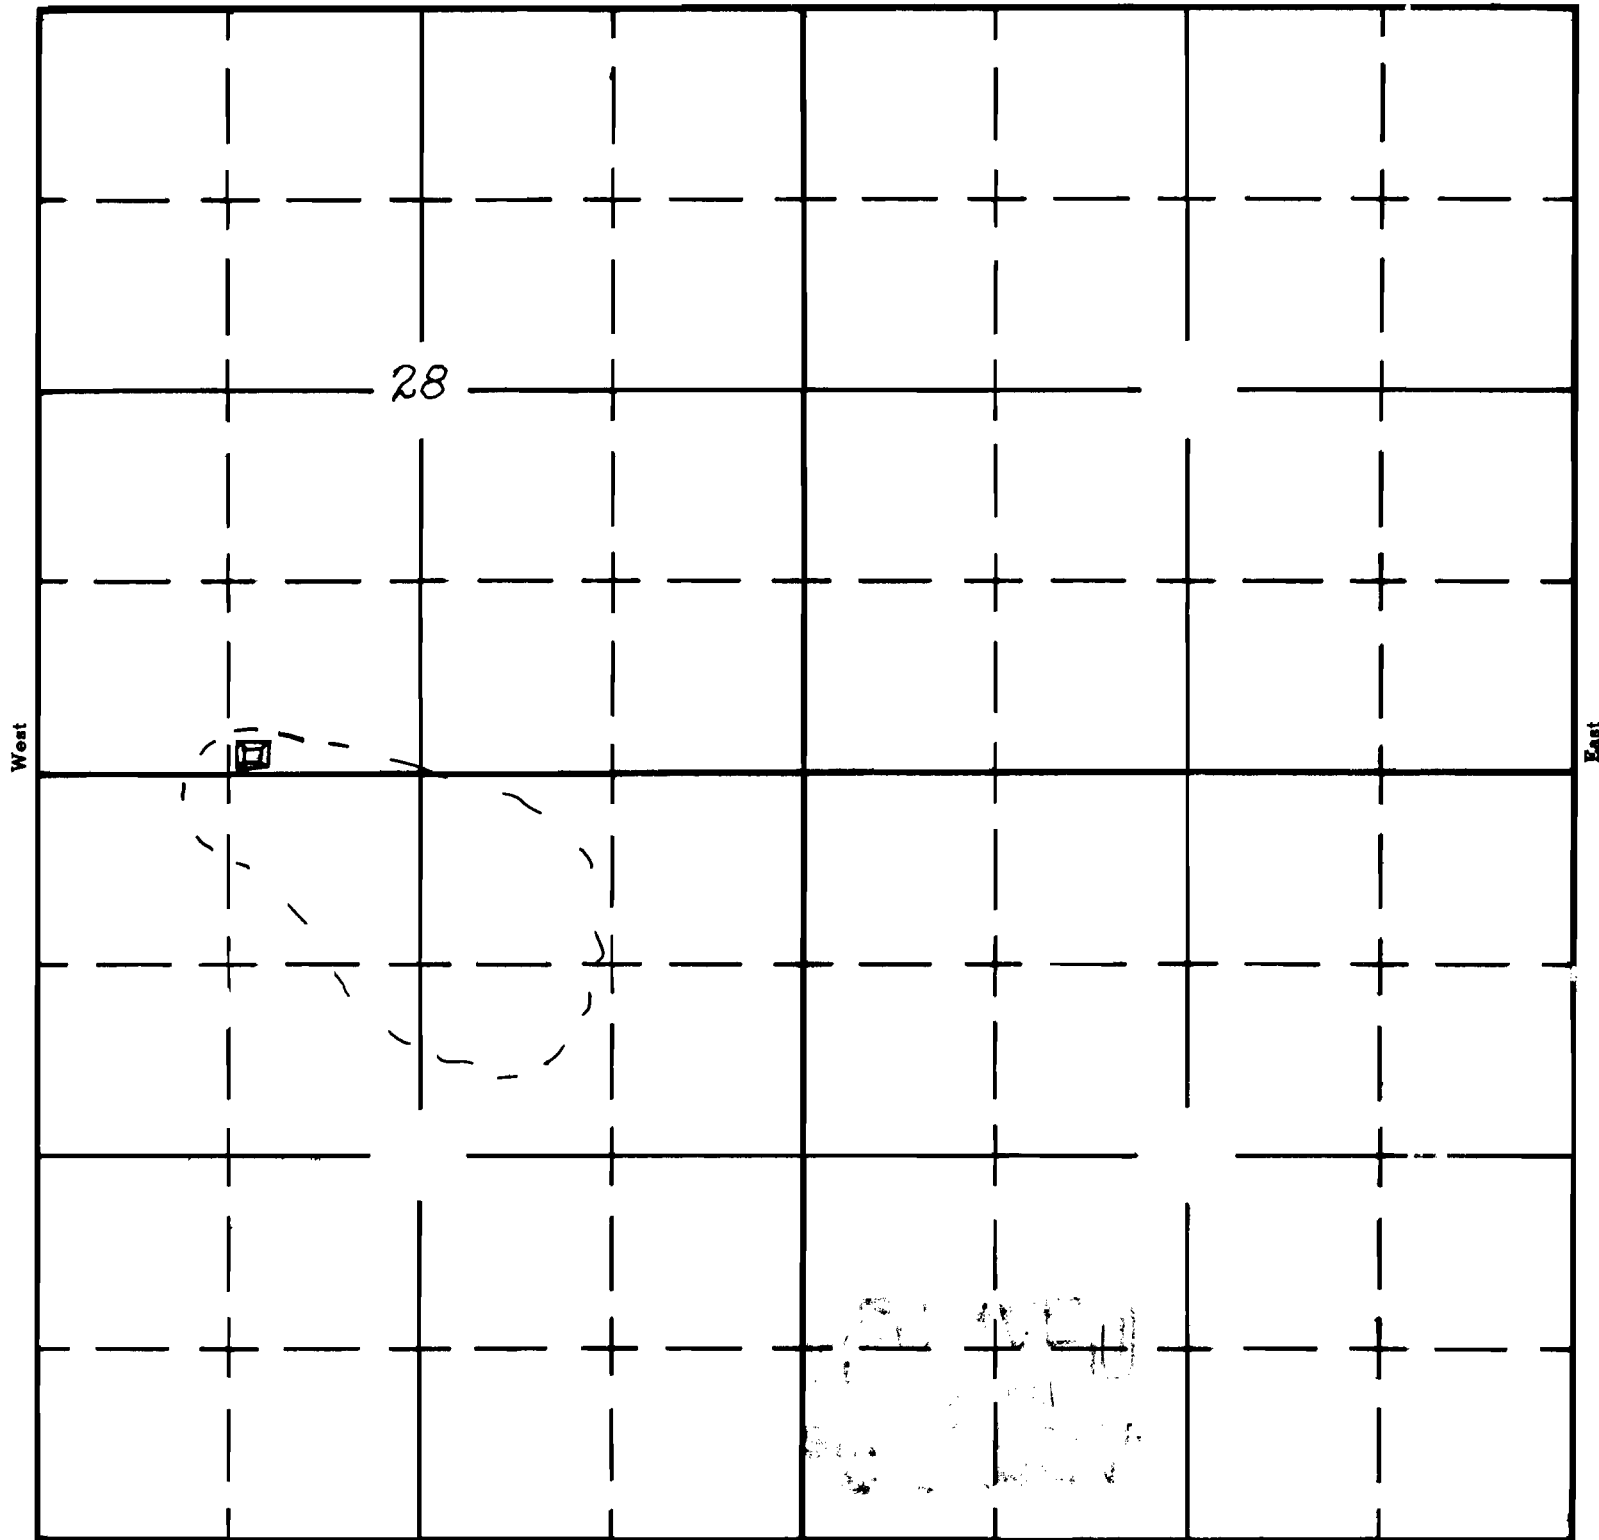

South

APPLICATION No. R-35847

PERMIT No. R-3492