

Form A1-187
March 1961

UNITED STATES
DEPARTMENT OF THE INTERIOR
BUREAU OF LAND MANAGEMENT

SECTION


SW¹₄ SW¹₄

Oregon State Water Filings

SEC 2

TOWNSHIP 24S, RANGE 26E, W. M.

North

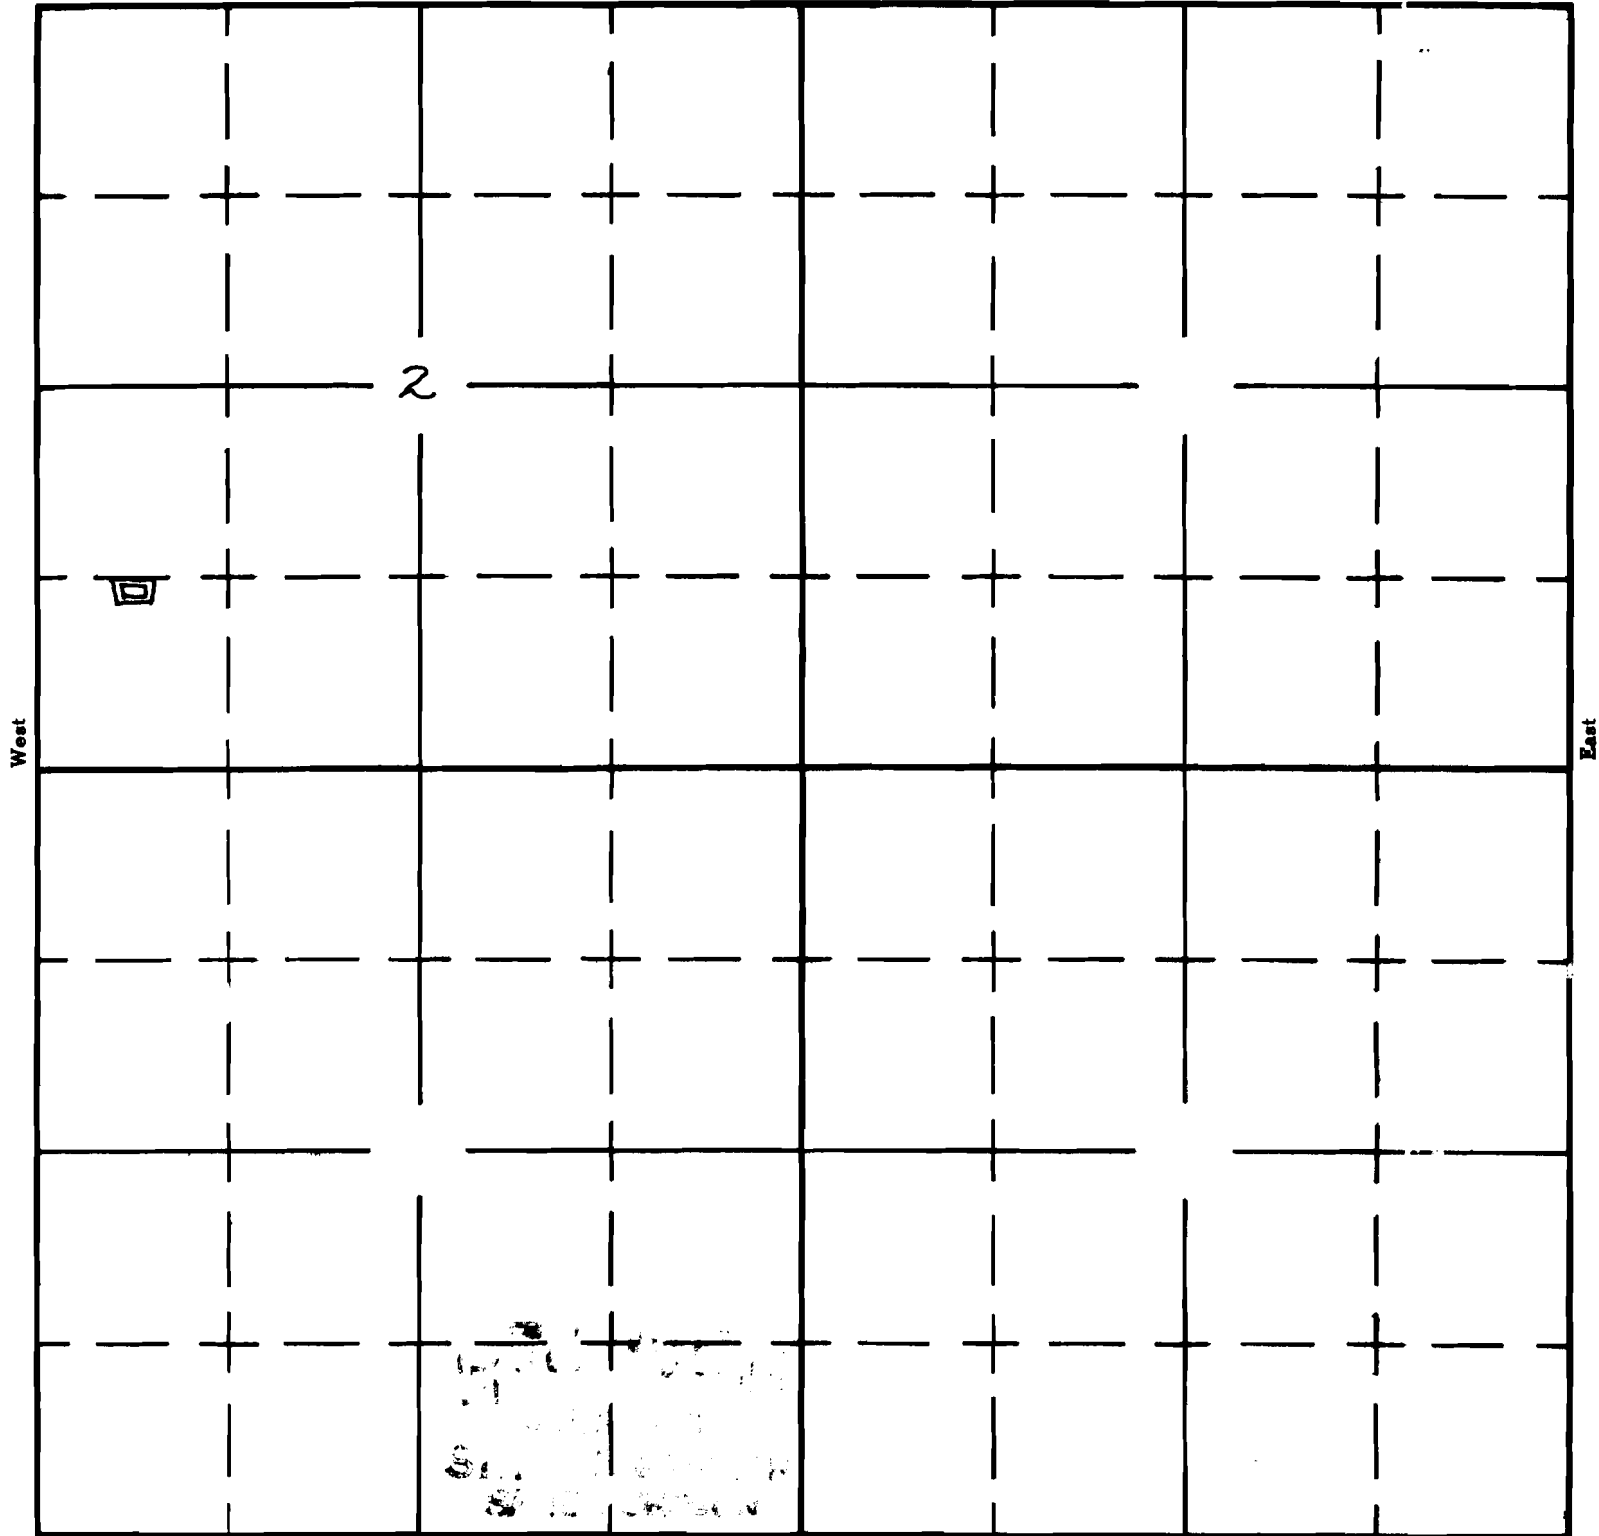

South

APPLICATION No. R-35857

PERMIT No. R-3495