

UNITED STATES
DEPARTMENT OF THE INTERIOR
BUREAU OF LAND MANAGEMENT

SECTION


NW 1/4 NE 1/4

SEC 30

Oregon State Water Filings

TOWNSHIP 24 S, RANGE 24 E, W. M.

North

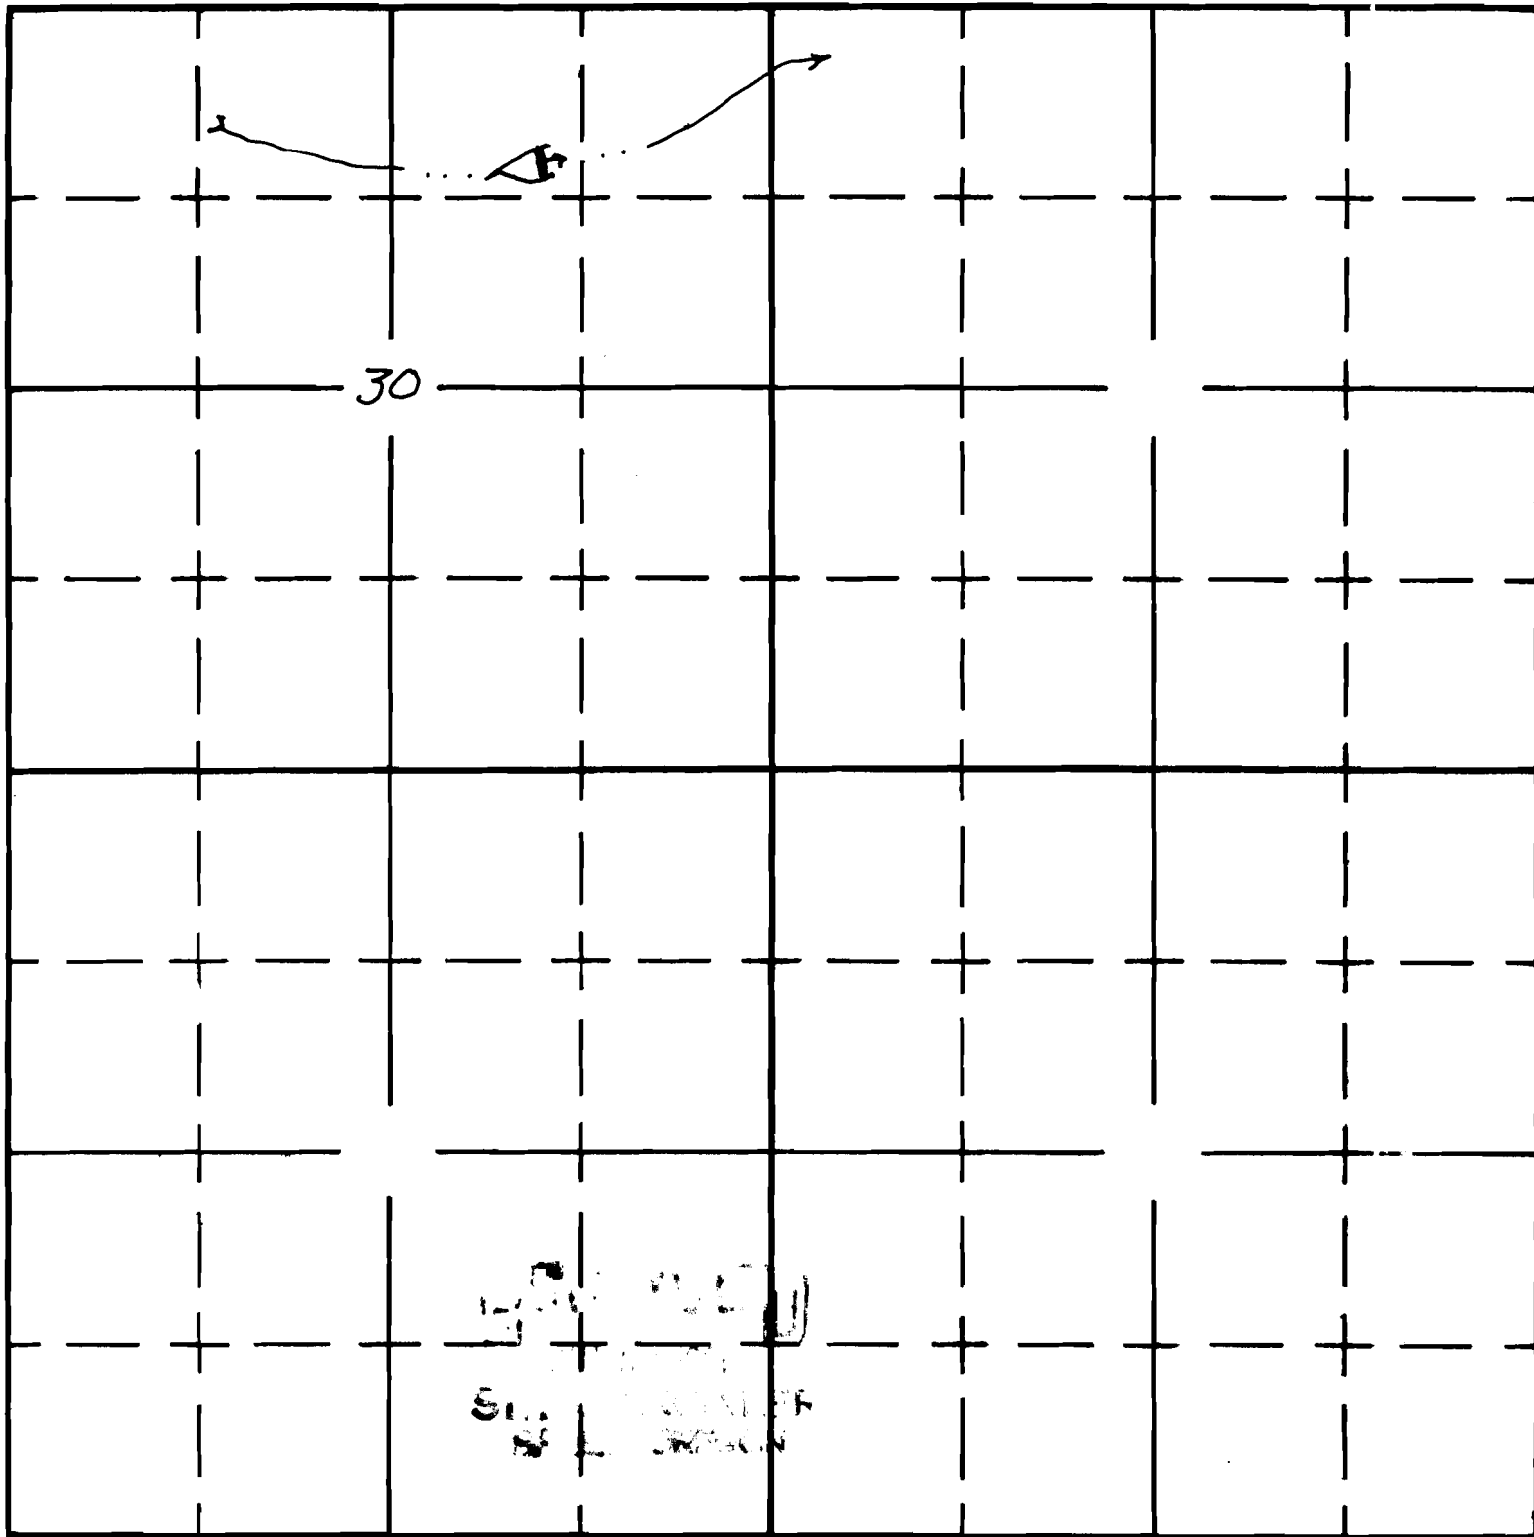

South

APPLICATION No. R-35858

PERMIT No. R-3496