

Form A1-187
March 1961

UNITED STATES
DEPARTMENT OF THE INTERIOR
BUREAU OF LAND MANAGEMENT

SECTION


NW $\frac{1}{4}$ SW $\frac{1}{4}$

SEC 25

Oregon State Water Filings

TOWNSHIP 24S, RANGE 24E, W. M.

North

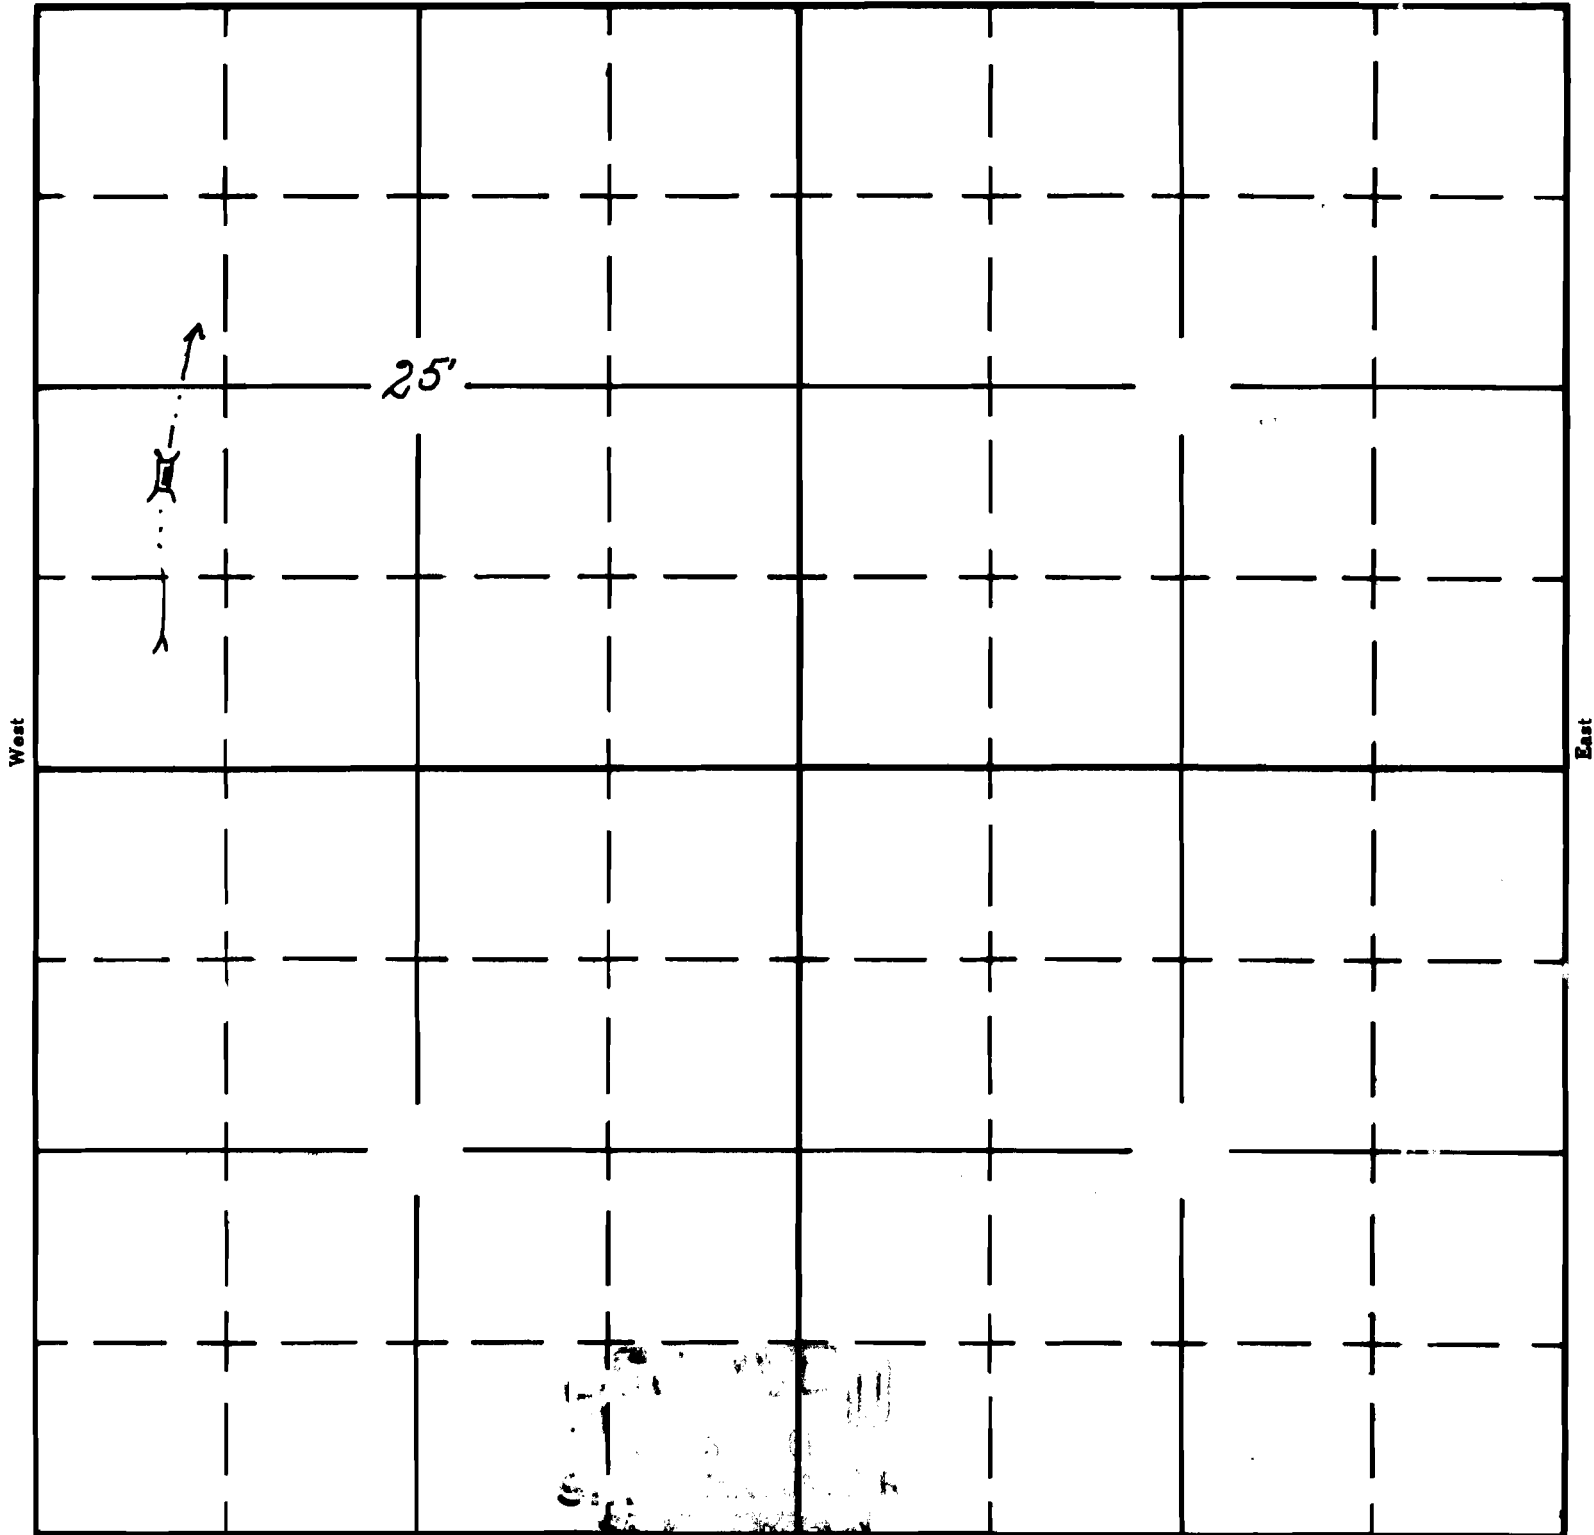

South

APPLICATION No. R-35859

PERMIT No. R-3497