

Form AI-187  
March 1961

UNITED STATES  
DEPARTMENT OF THE INTERIOR  
BUREAU OF LAND MANAGEMENT

SECTION


NE  $\frac{1}{4}$  NE  $\frac{1}{4}$

SEC 15


TOWNSHIP 25 S, RANGE 28 E, W. M.

North

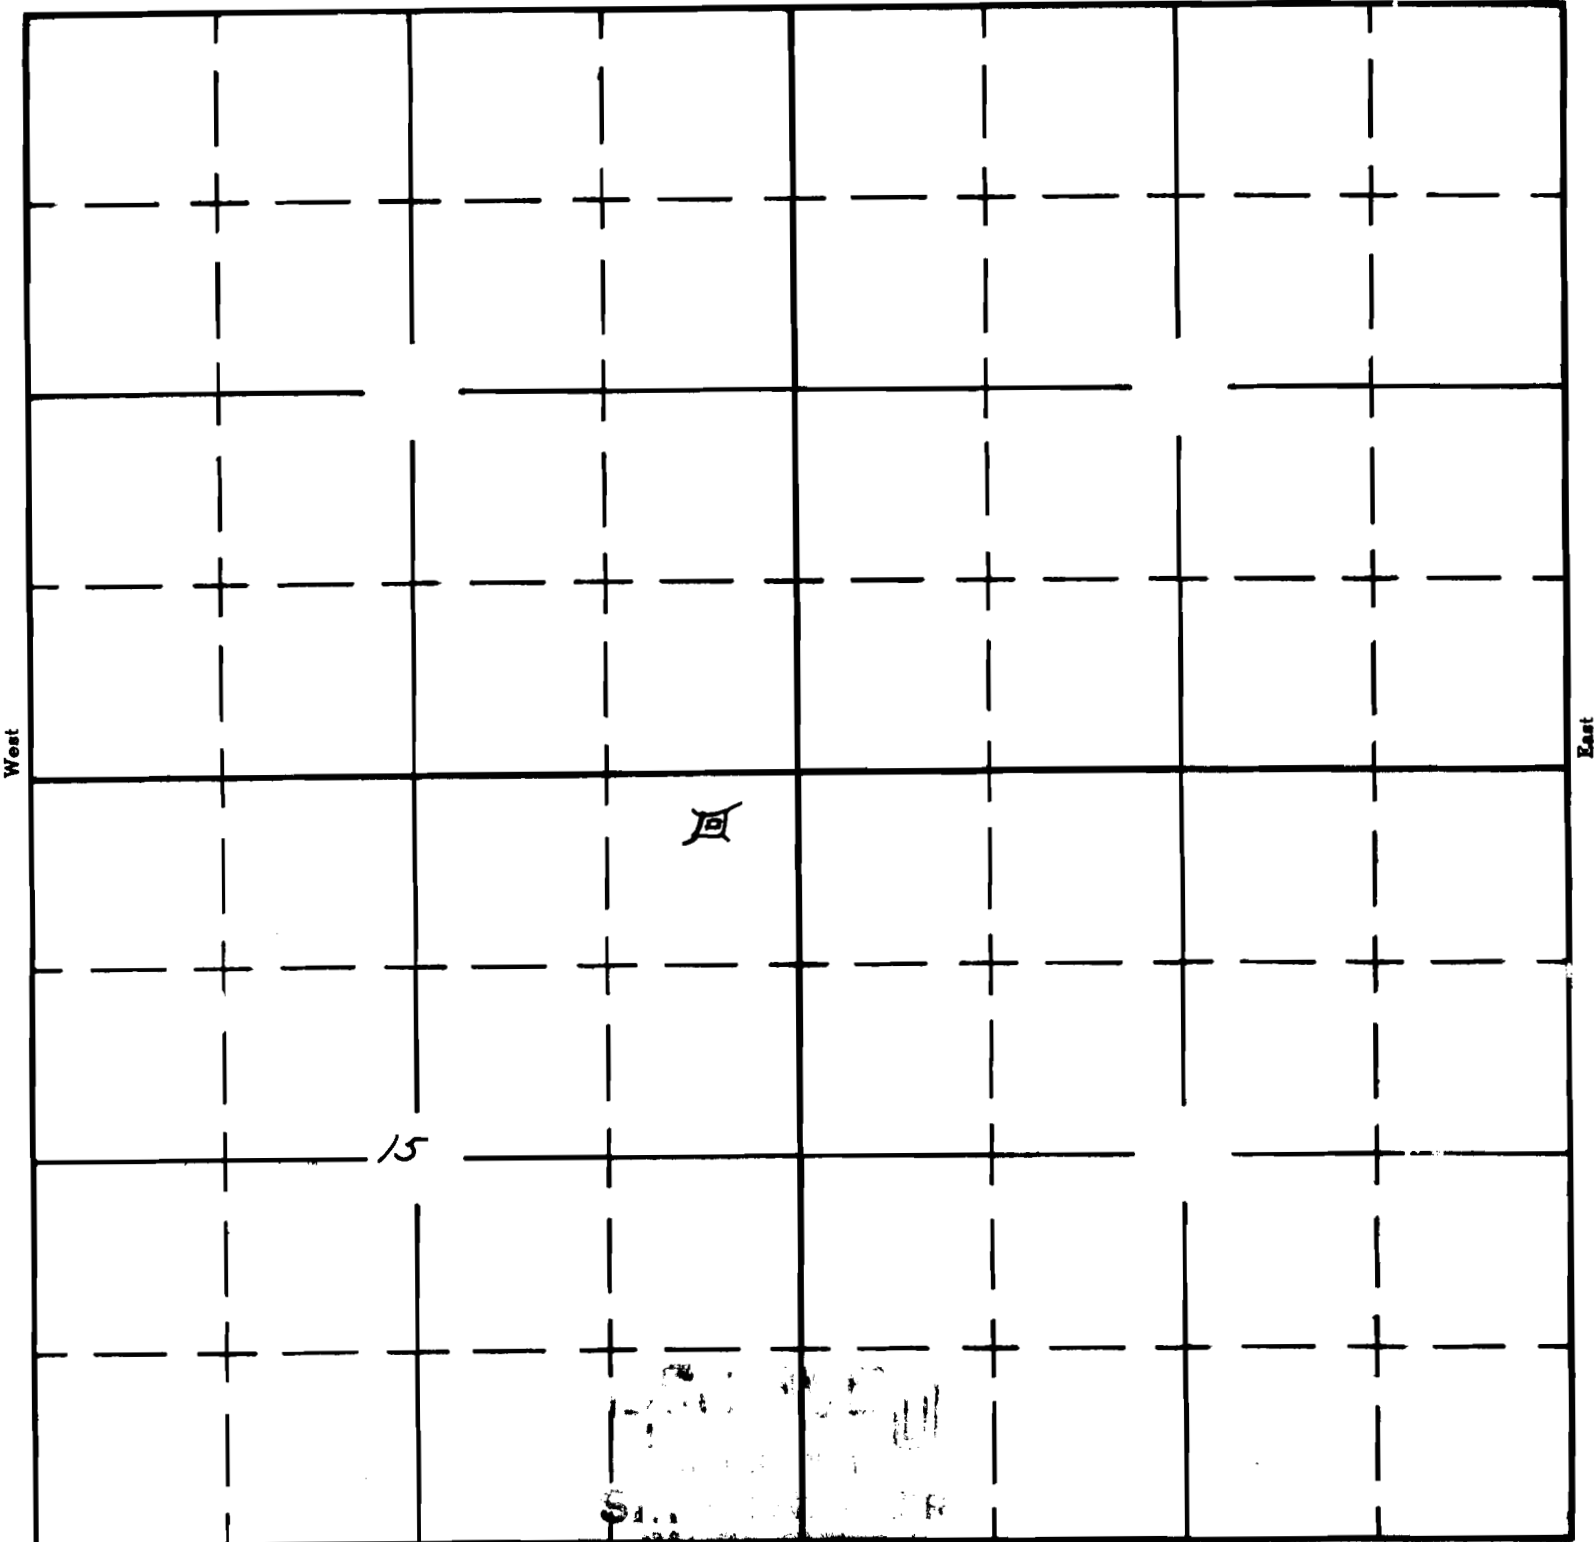

South

APPLICATION No. R-35862  
PERMIT No. R-3498