


orm A1-187
March 1961

UNITED STATES
DEPARTMENT OF THE INTERIOR
BUREAU OF LAND MANAGEMENT

SECTION
SE 1/4 SE 1/4
SEC. 8

Oregon State Water Filings

TOWNSHIP 23S, RANGE 27E, W. M.

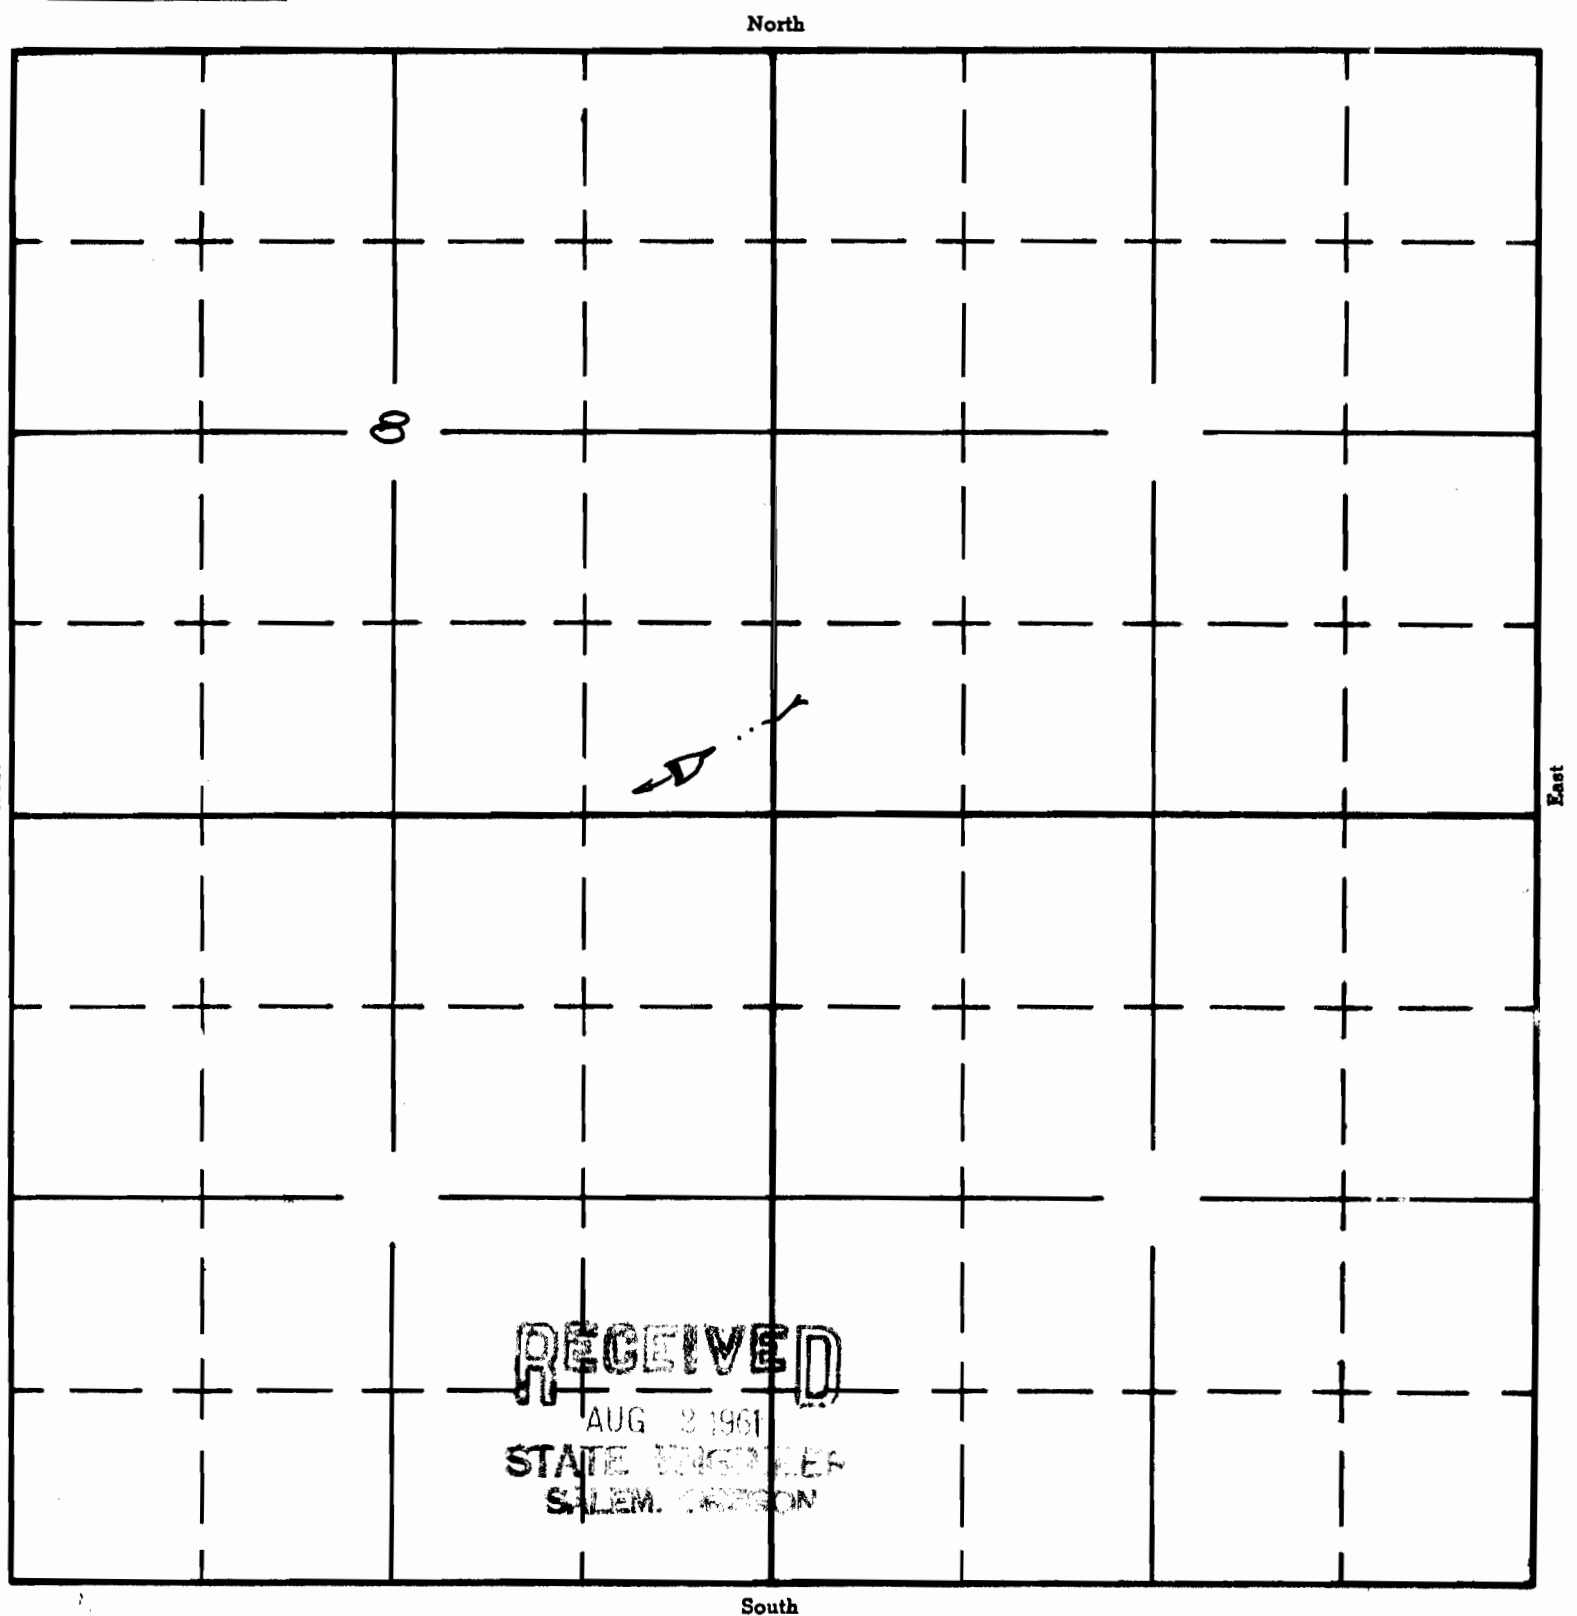

APPLICATION No. A-36016
PERMIT No. A-3537