


Form A1-187
March 1961

UNITED STATES
DEPARTMENT OF THE INTERIOR
BUREAU OF LAND MANAGEMENT

SECTION
NE¹ NE⁴
SEC. 25

Oregon State Water Filings

TOWNSHIP 25S, RANGE 25E, W. M.

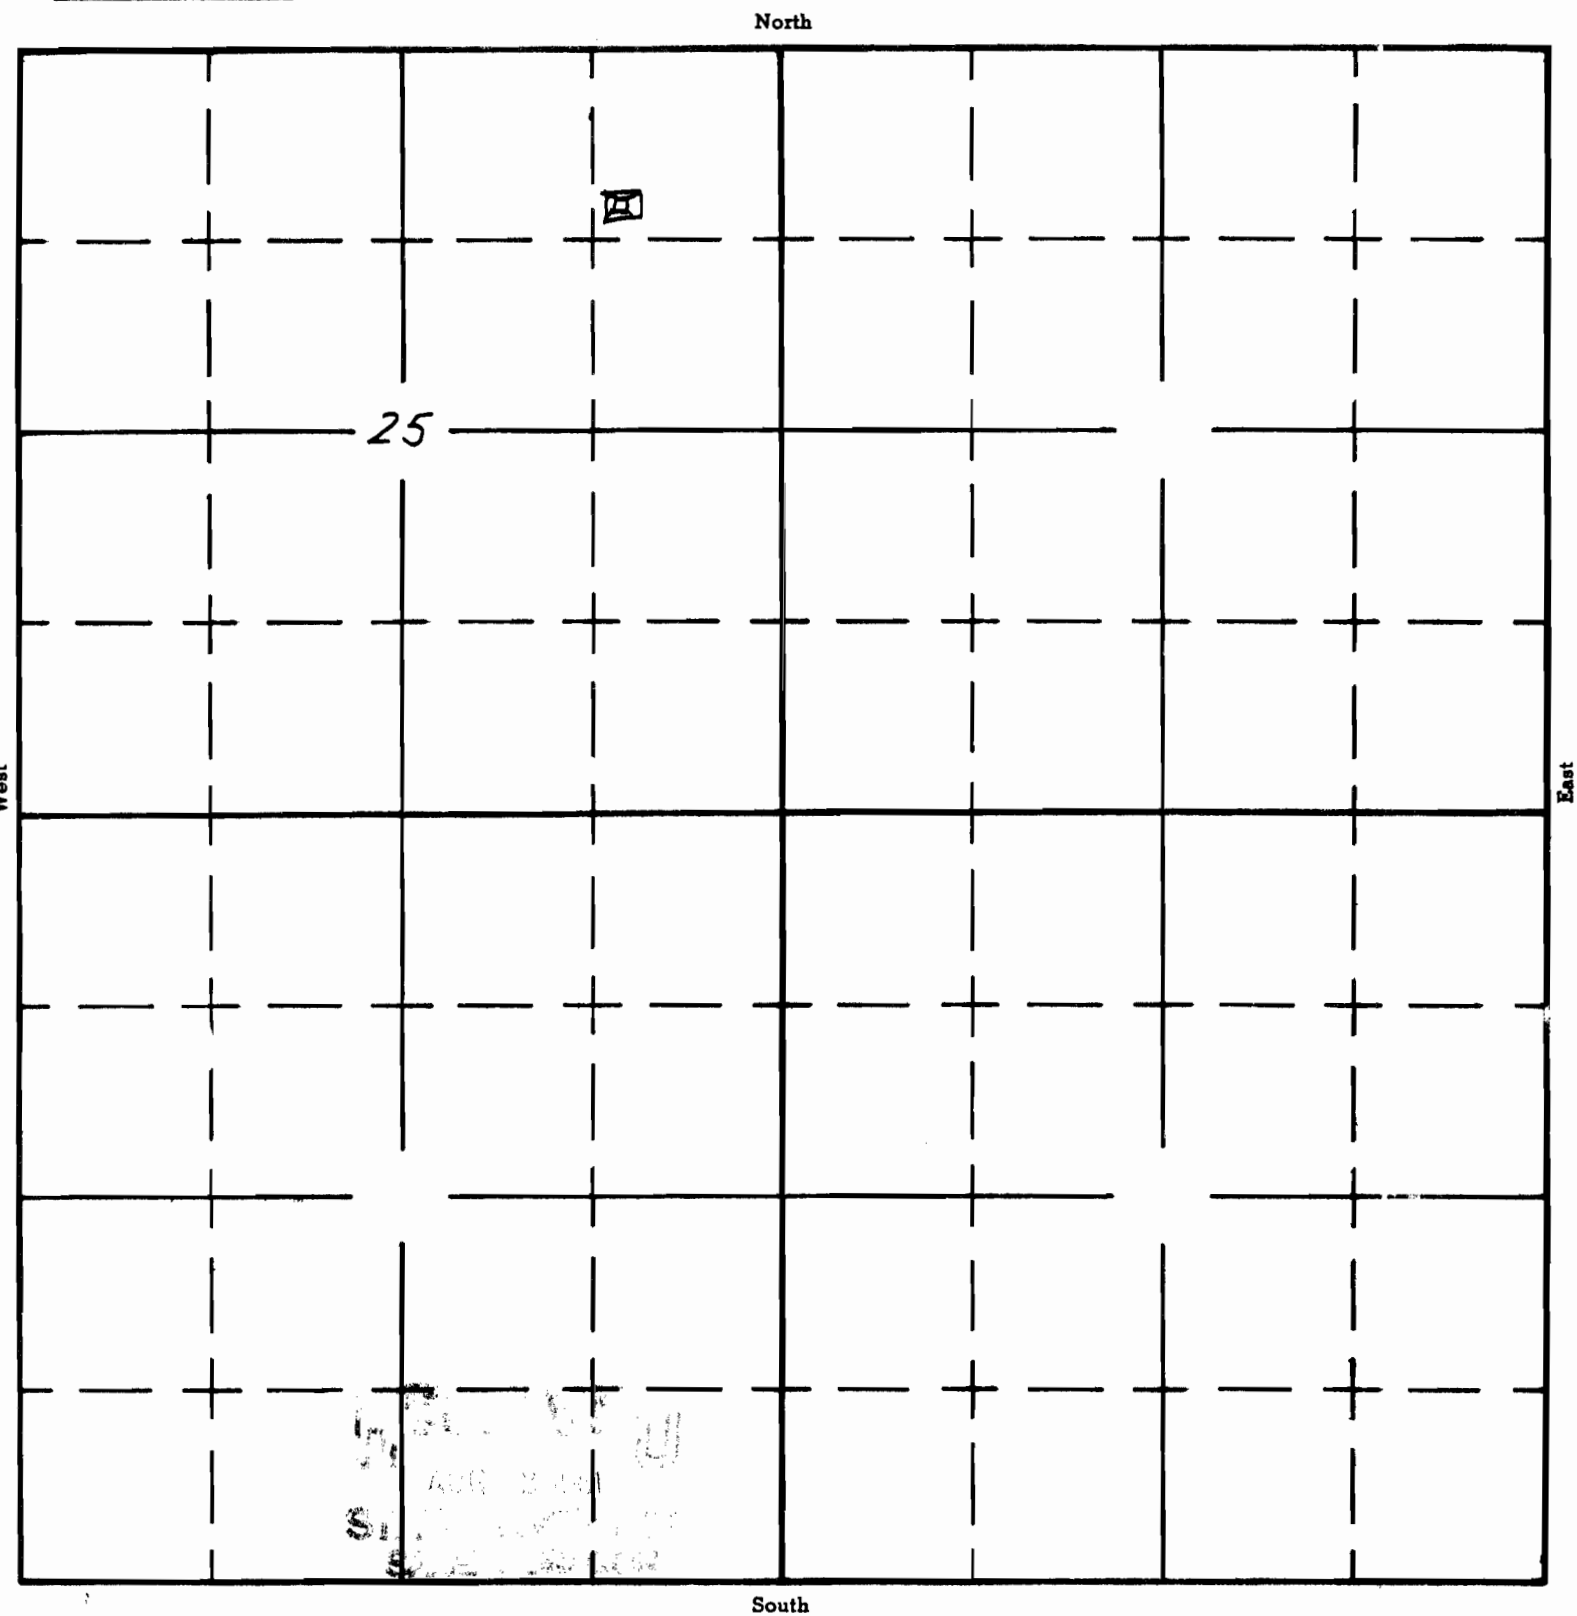

APPLICATION No. R-36022
PERMIT No. R-3540