

UNITED STATES
DEPARTMENT OF THE INTERIOR
BUREAU OF LAND MANAGEMENT

SECTION


SE 1/4 NW 1/4

SEC 31

Oregon State Water Filings

TOWNSHIP 28S, RANGE 29 1/2 E W. M.

North

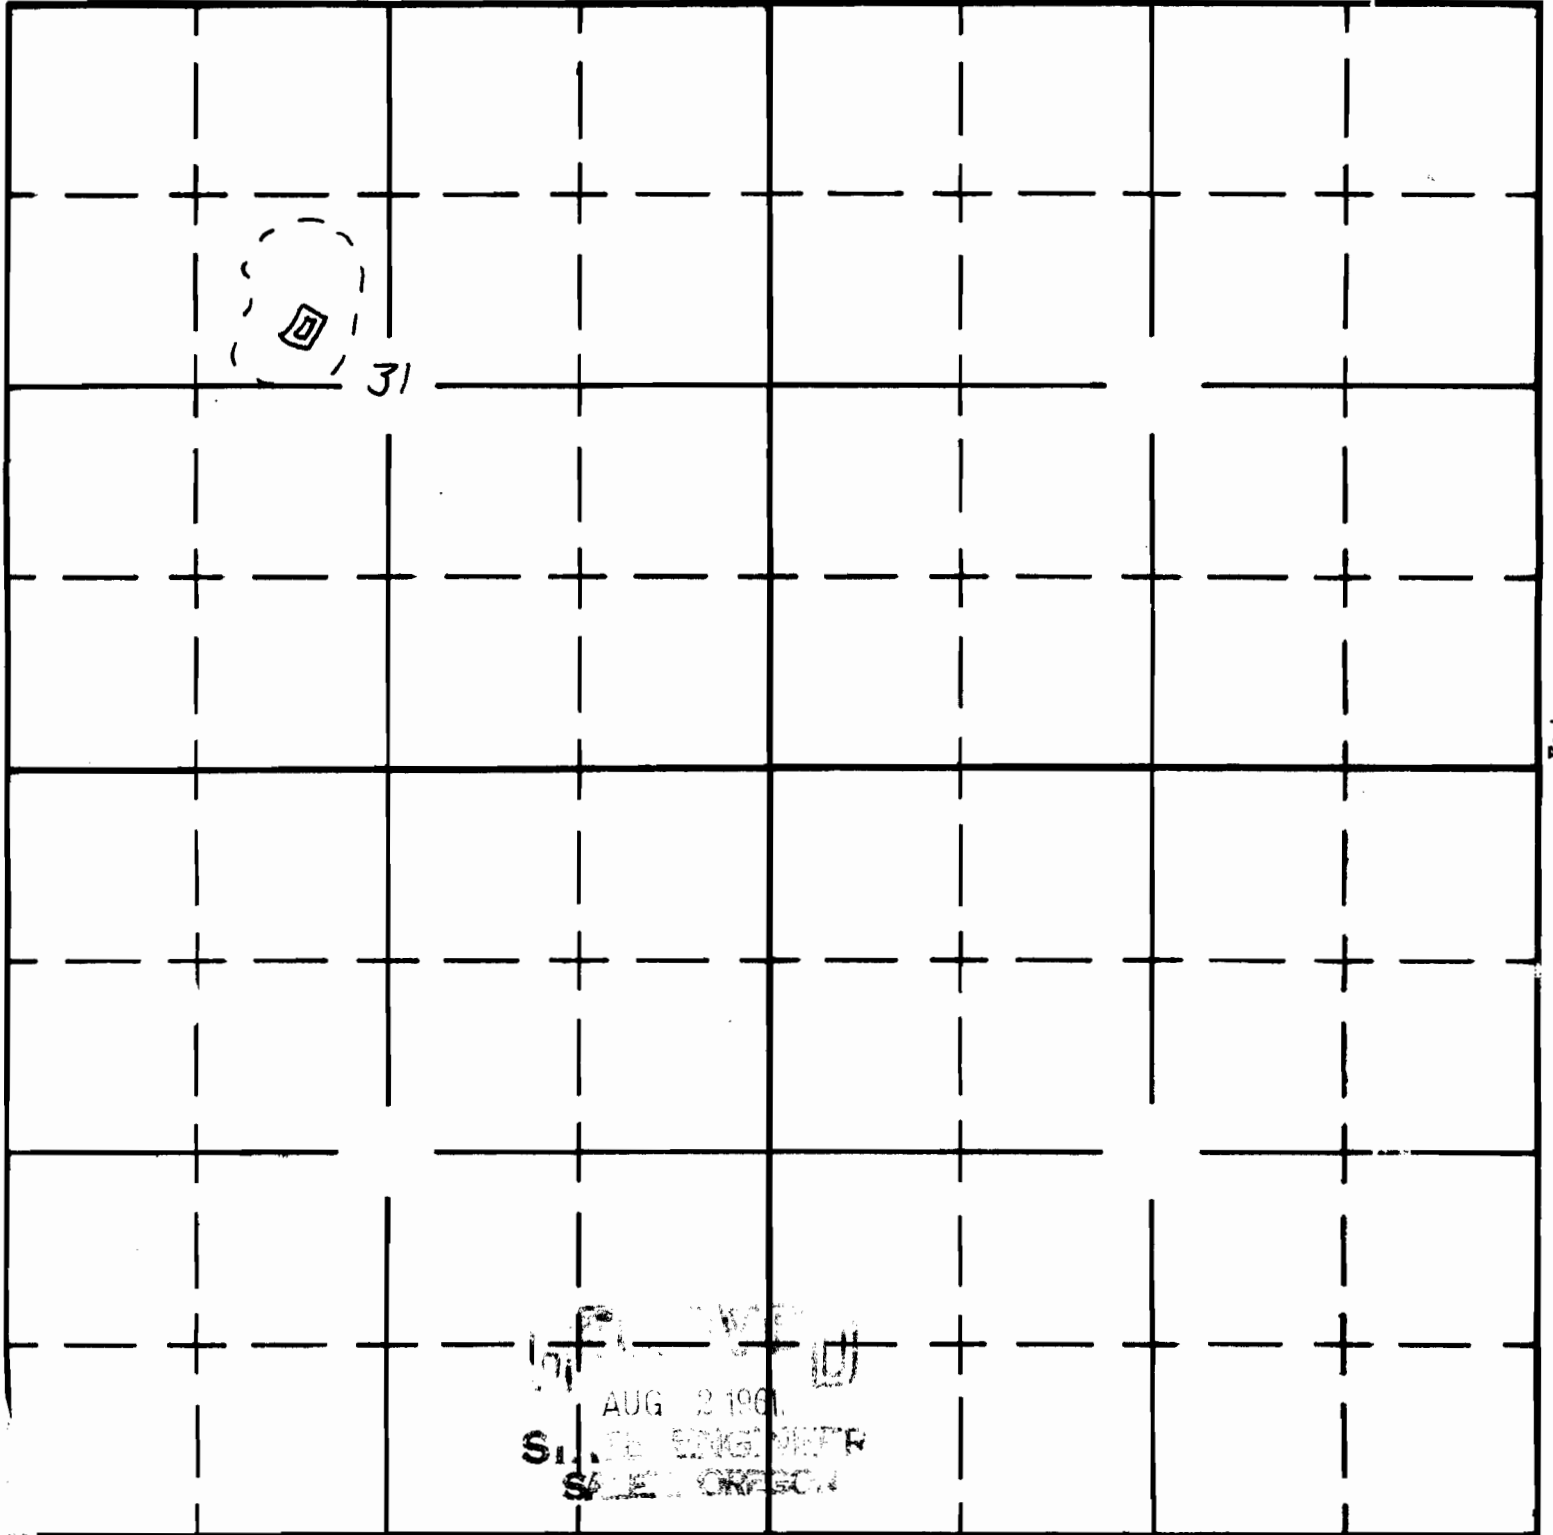

APPLICATION No. R-36054
PERMIT No. R-3549