


Form A1-187
March 1961

UNITED STATES
DEPARTMENT OF THE INTERIOR
BUREAU OF LAND MANAGEMENT

SECTION
NW 1/4 SW 1/4
SEC 14

Oregon State Water Filings

TOWNSHIP 25S, RANGE 27E, W. M.

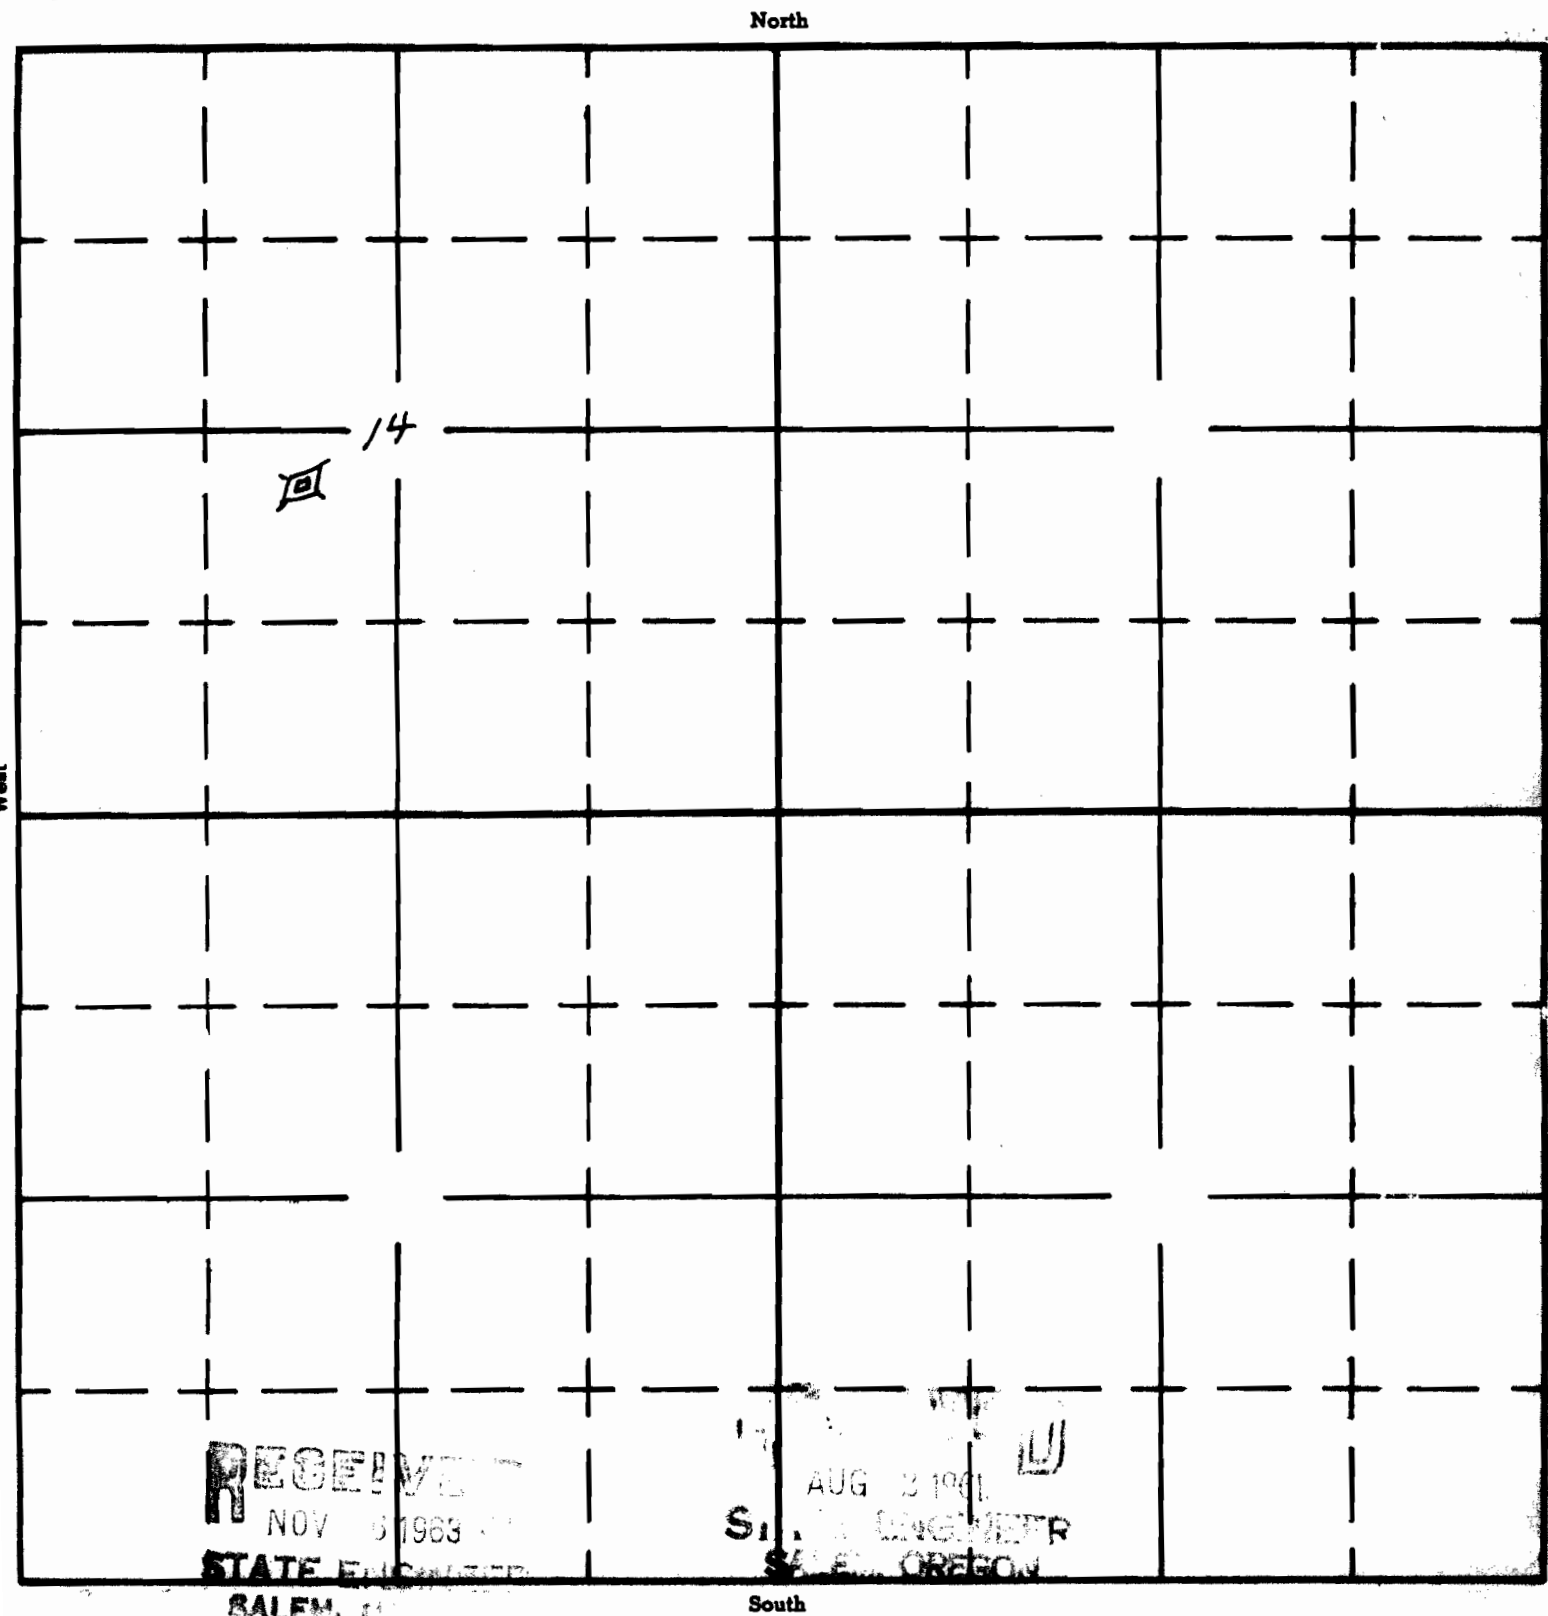

APPLICATION No. R-36058
PERMIT No. R-3852