

UNITED STATES
DEPARTMENT OF THE INTERIOR
BUREAU OF LAND MANAGEMENT


SECTION

SW 1/4 NW 1/4

Oregon State Water Filings

TOWNSHIP 30S, RANGE 30E, W. M.

North

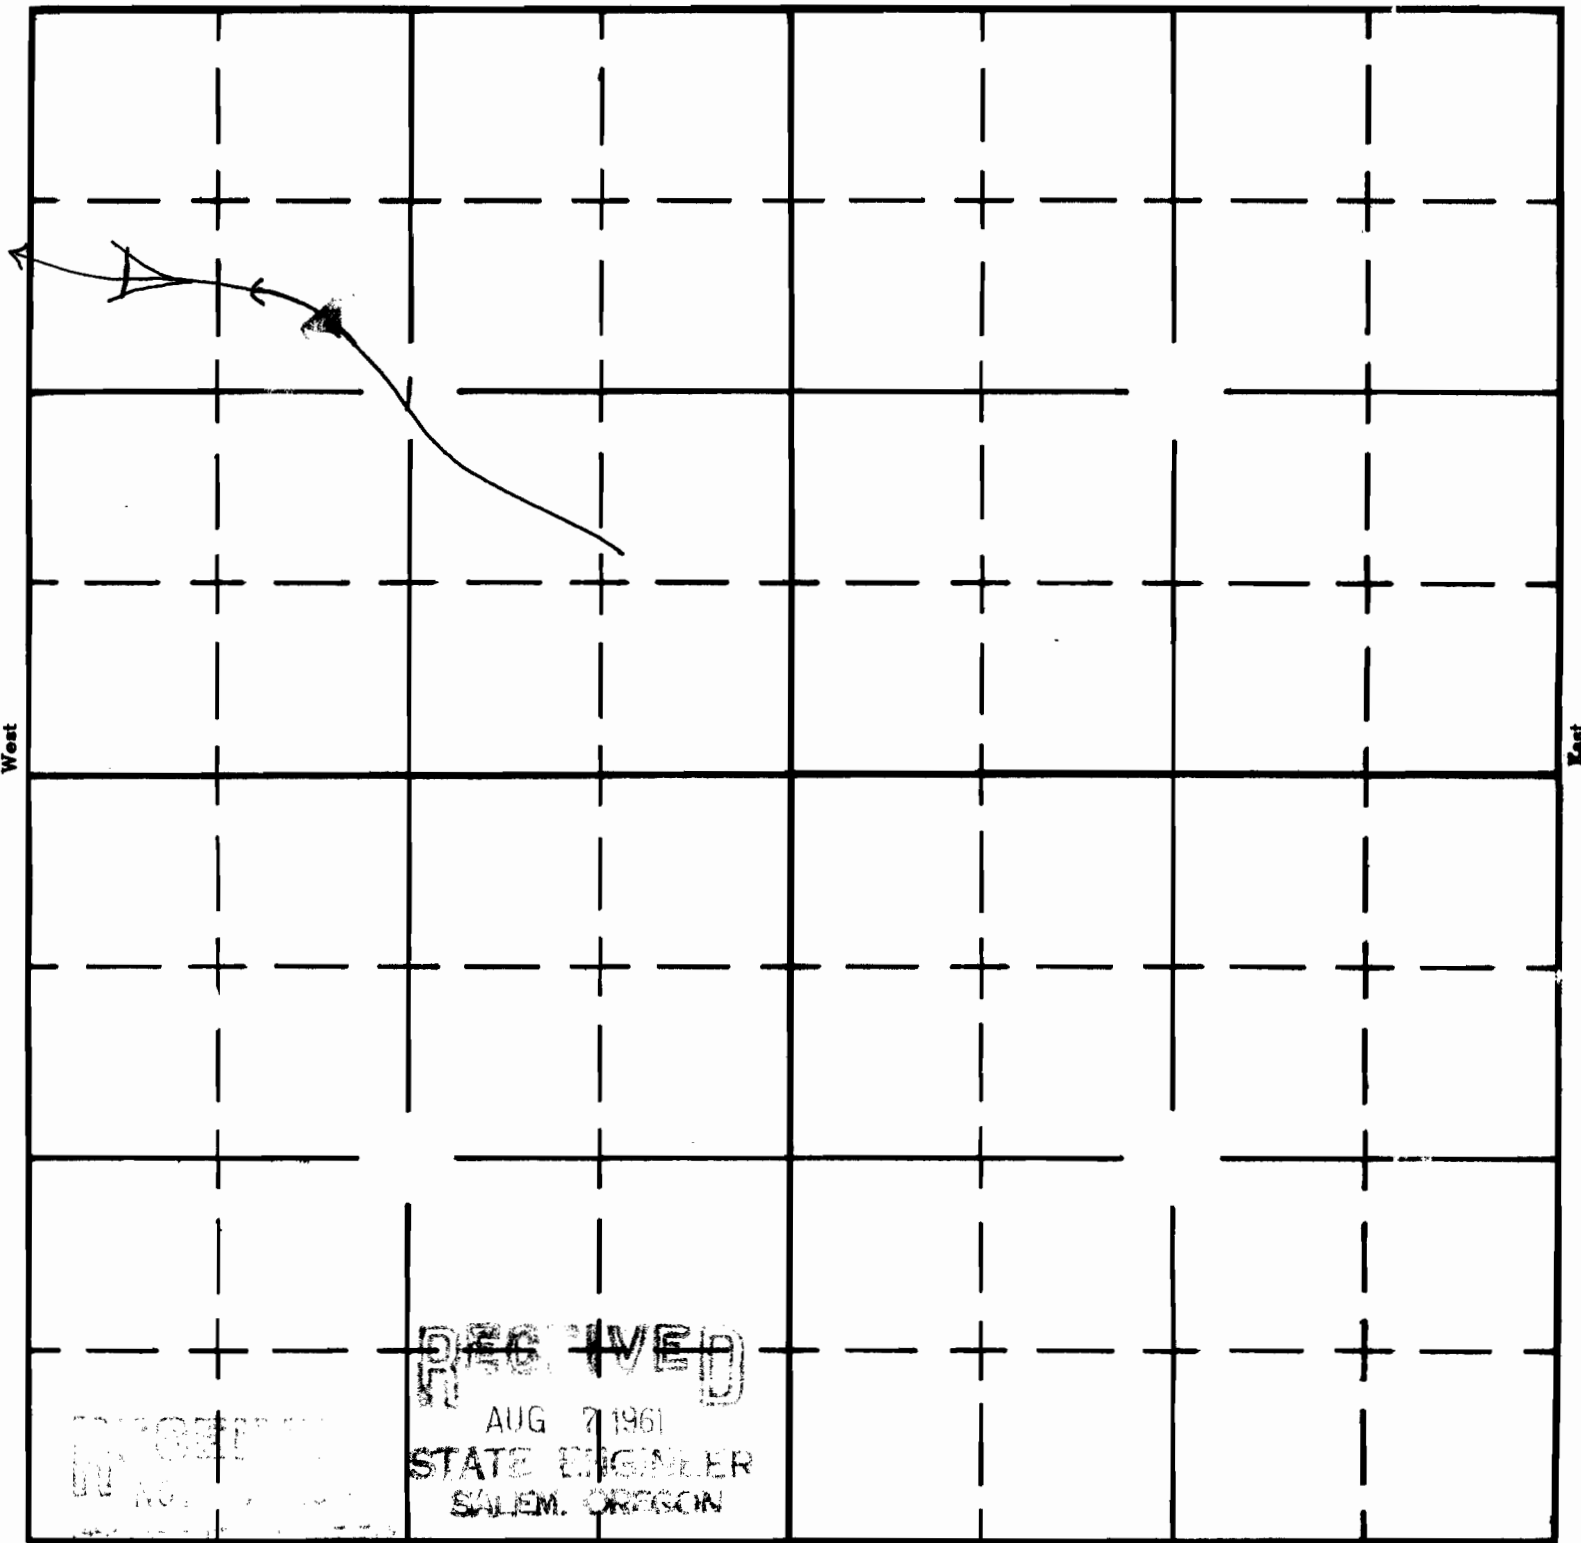

APPLICATION No. R-36113
PERMIT No. R-3565