

Form AI-187
March 1961

UNITED STATES
DEPARTMENT OF THE INTERIOR
BUREAU OF LAND MANAGEMENT

SECTION


14

Oregon State Water Filings

SW 1/4 SW 1/4

TOWNSHIP 37S, RANGE 28E, W. M.

Tied in with aerial photos & U.S.N.D. Quad Maps.

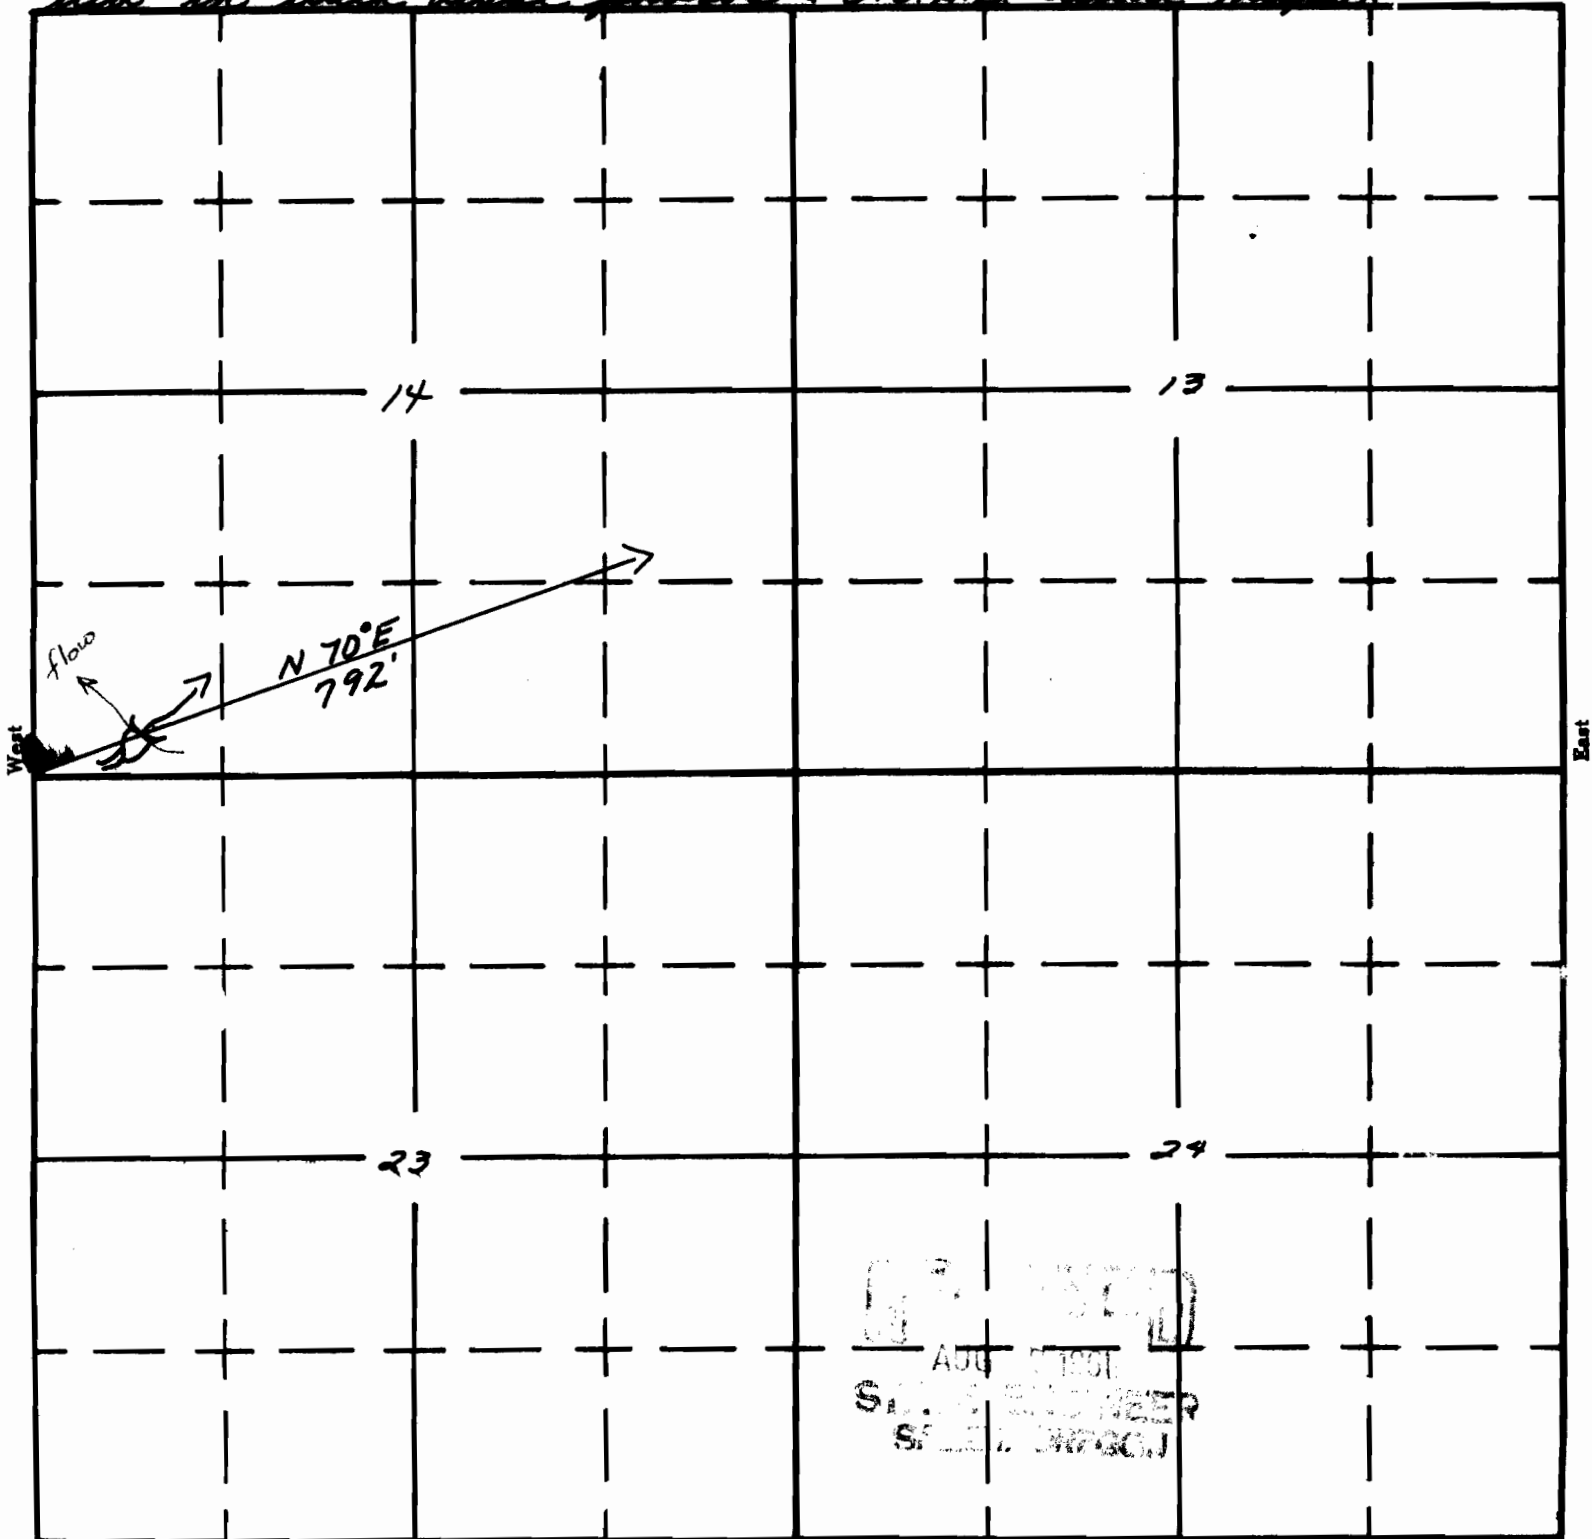

APR 1961
S.W. ENGINEER
S.W. ENGINEER

South

APPLICATION No. R-26235

PERMIT No. R-3579