

UNITED STATES
DEPARTMENT OF THE INTERIOR
BUREAU OF LAND MANAGEMENT


SECTION 11

Oregon State Water Filings

NW¹/₄ NW¹/₄

TOWNSHIP 38S, RANGE 29E, W. M.

Tied in with aerial photos: O.S.H.D. Quad Maps

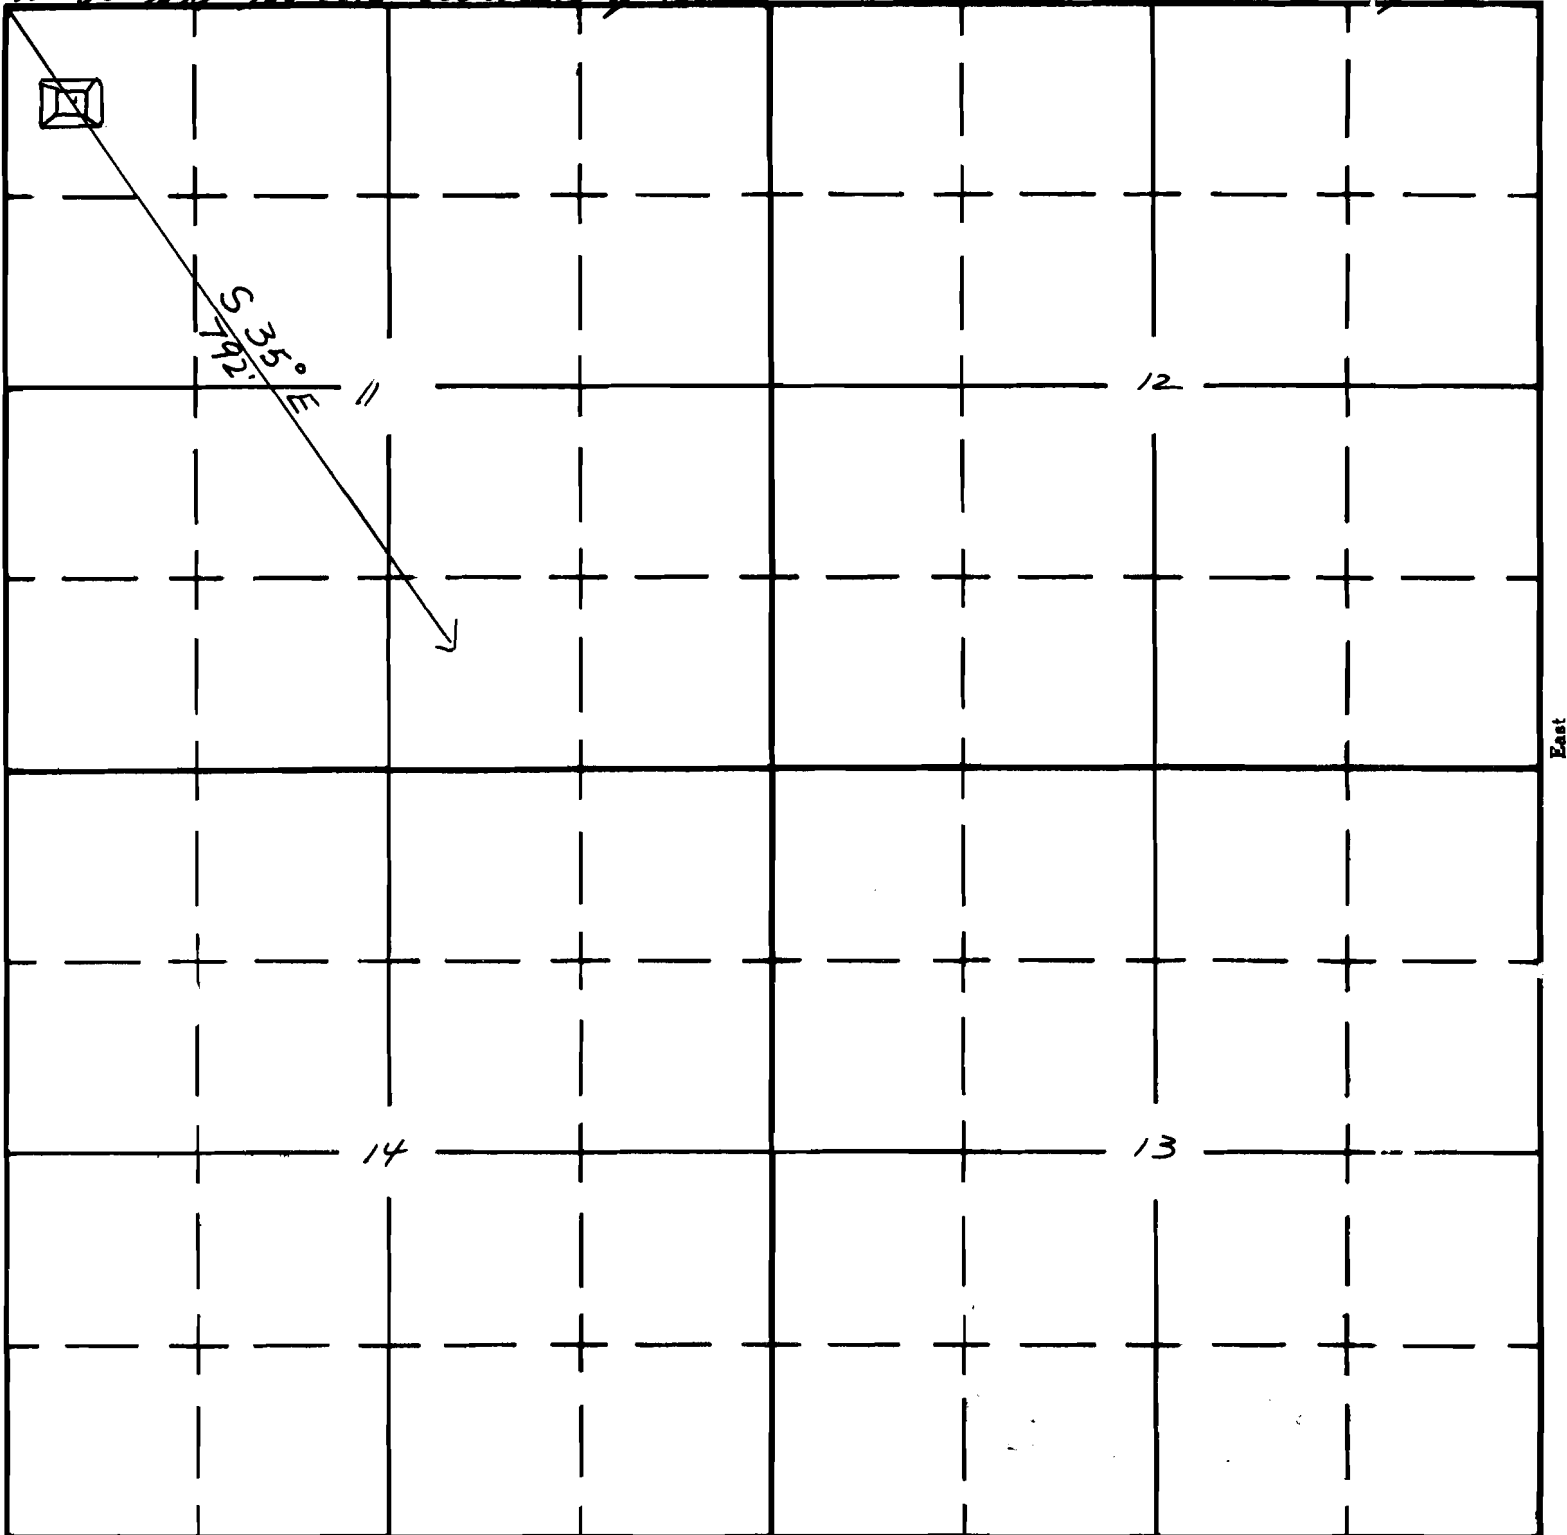

South

APPLICATION No. R-36264
PERMIT No. R-3590