

Form AI-187
March 1961

UNITED STATES
DEPARTMENT OF THE INTERIOR
BUREAU OF LAND MANAGEMENT

SECTION


Oregon State Water Filings

NE 1/4 SW 1/4

TOWNSHIP 30S, RANGE 2 1/2E W. M.

Sec. 31

North

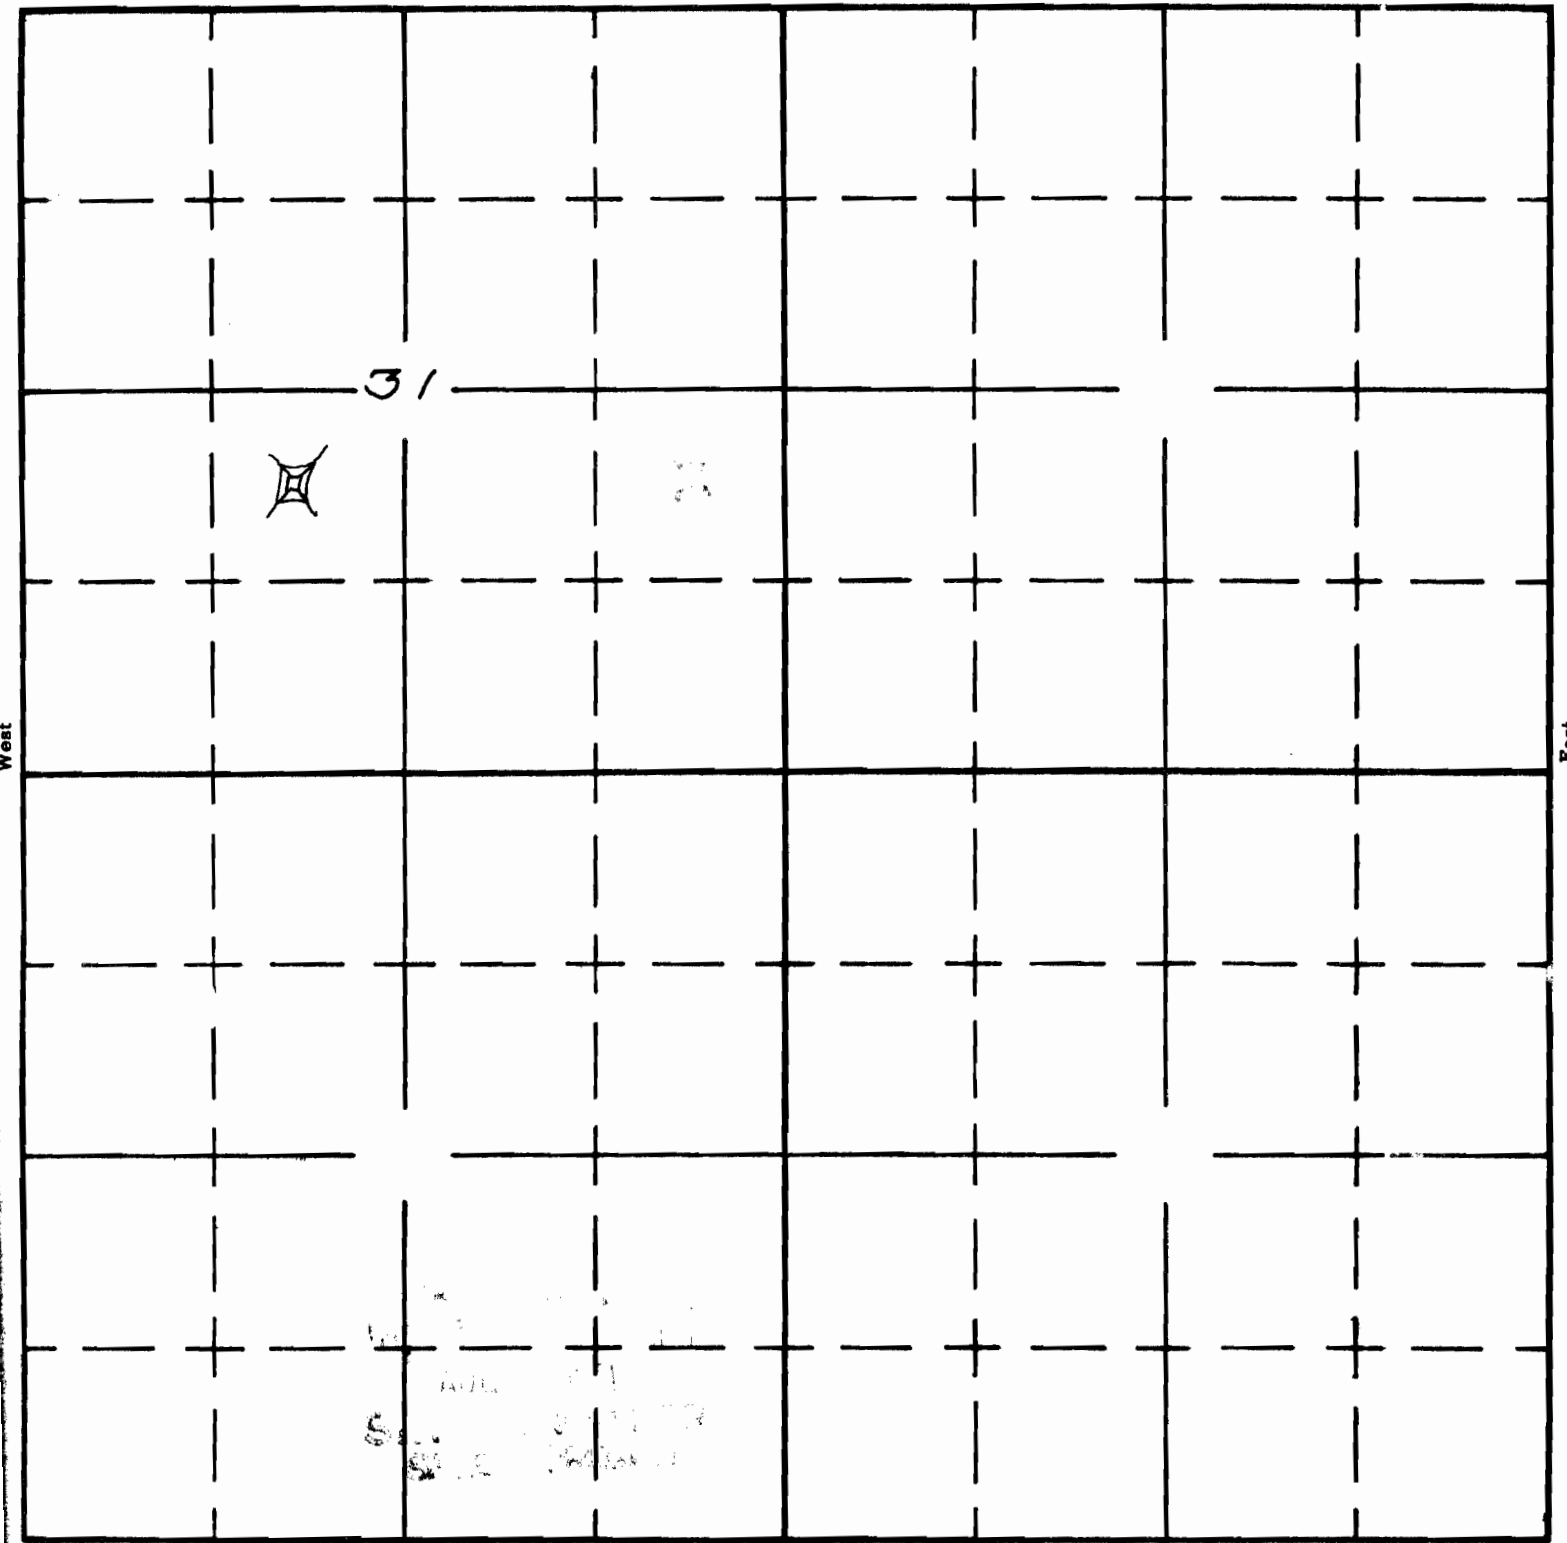

South

APPLICATION No. **R-35923**

PERMIT No. **R-3706**