


UNITED STATES
DEPARTMENT OF THE INTERIOR
BUREAU OF LAND MANAGEMENT

Section 19
SW 1/4 NW 1/4

Township 30 S.
Range 28 E.

Appl. No. R-35928
Permit No. R-3707

Will. Mer.

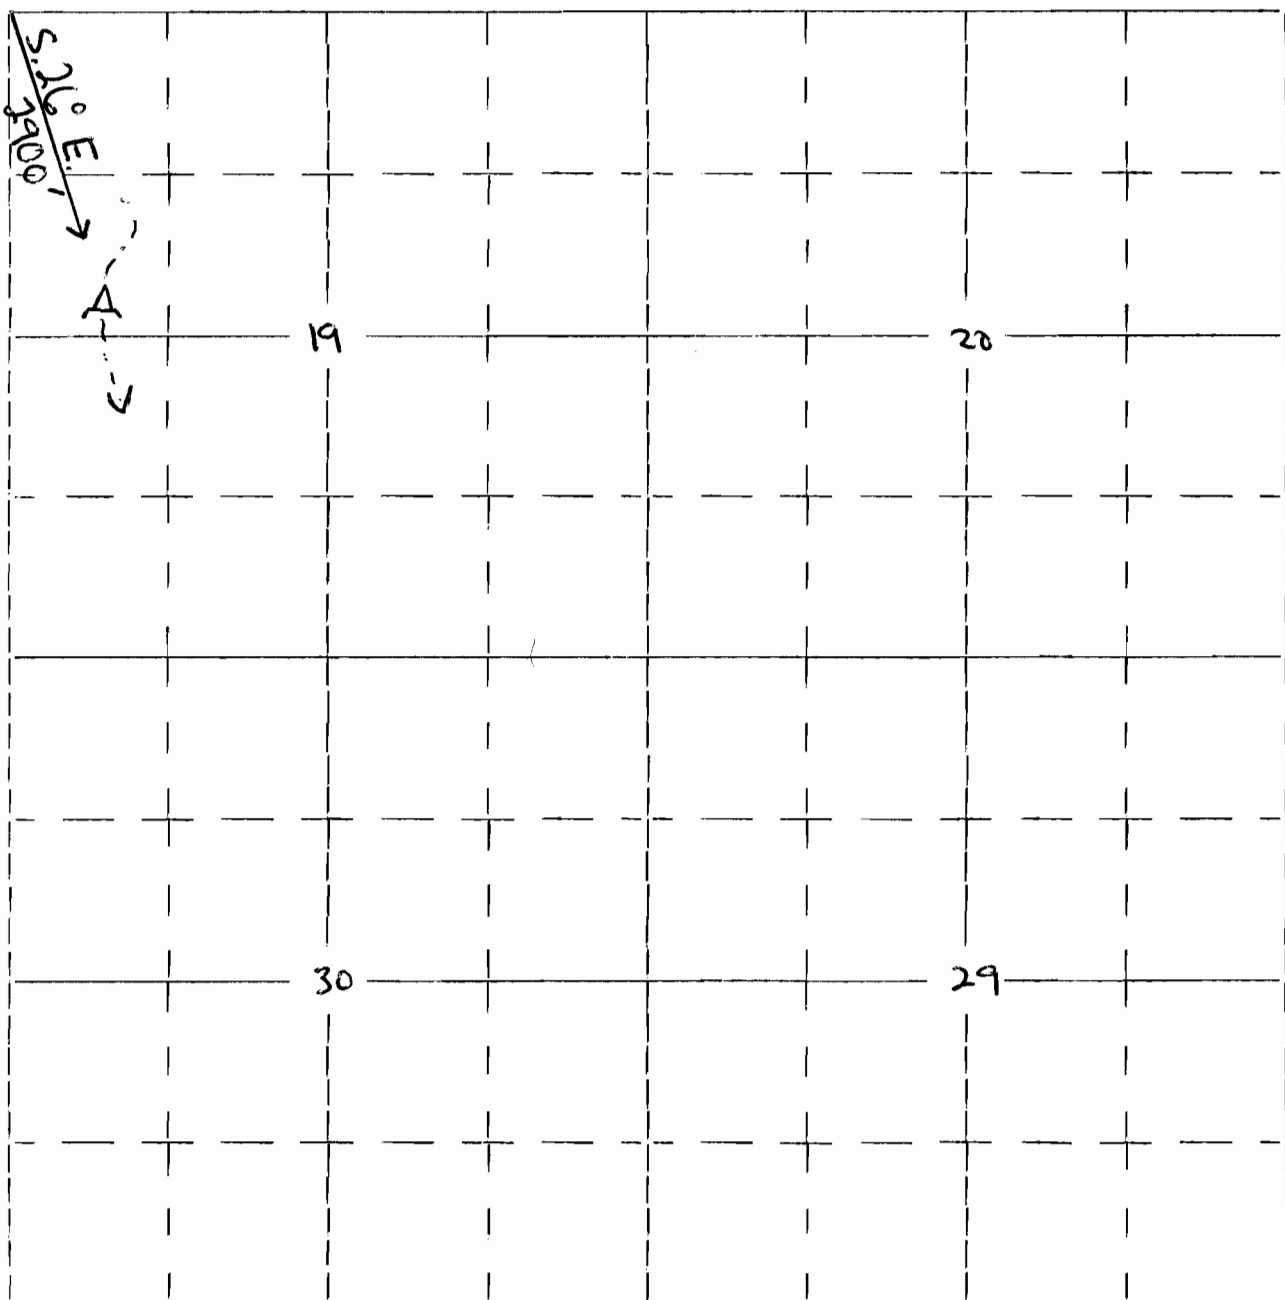

4" = 1 mile

Edw 5/13/83