

03 -187
1961

UNITED STATES
DEPARTMENT OF THE INTERIOR
BUREAU OF LAND MANAGEMENT

SECTION

22


Oregon State Water Filings

SE $\frac{1}{4}$ NW $\frac{1}{4}$

TOWNSHIP 31S, RANGE 25E, W. M.

SW $\frac{1}{4}$ NE $\frac{1}{4}$

TIED-IN WITH AERIAL PHOTOS AND O.S.H.D. ^{North} QUAD MAPS

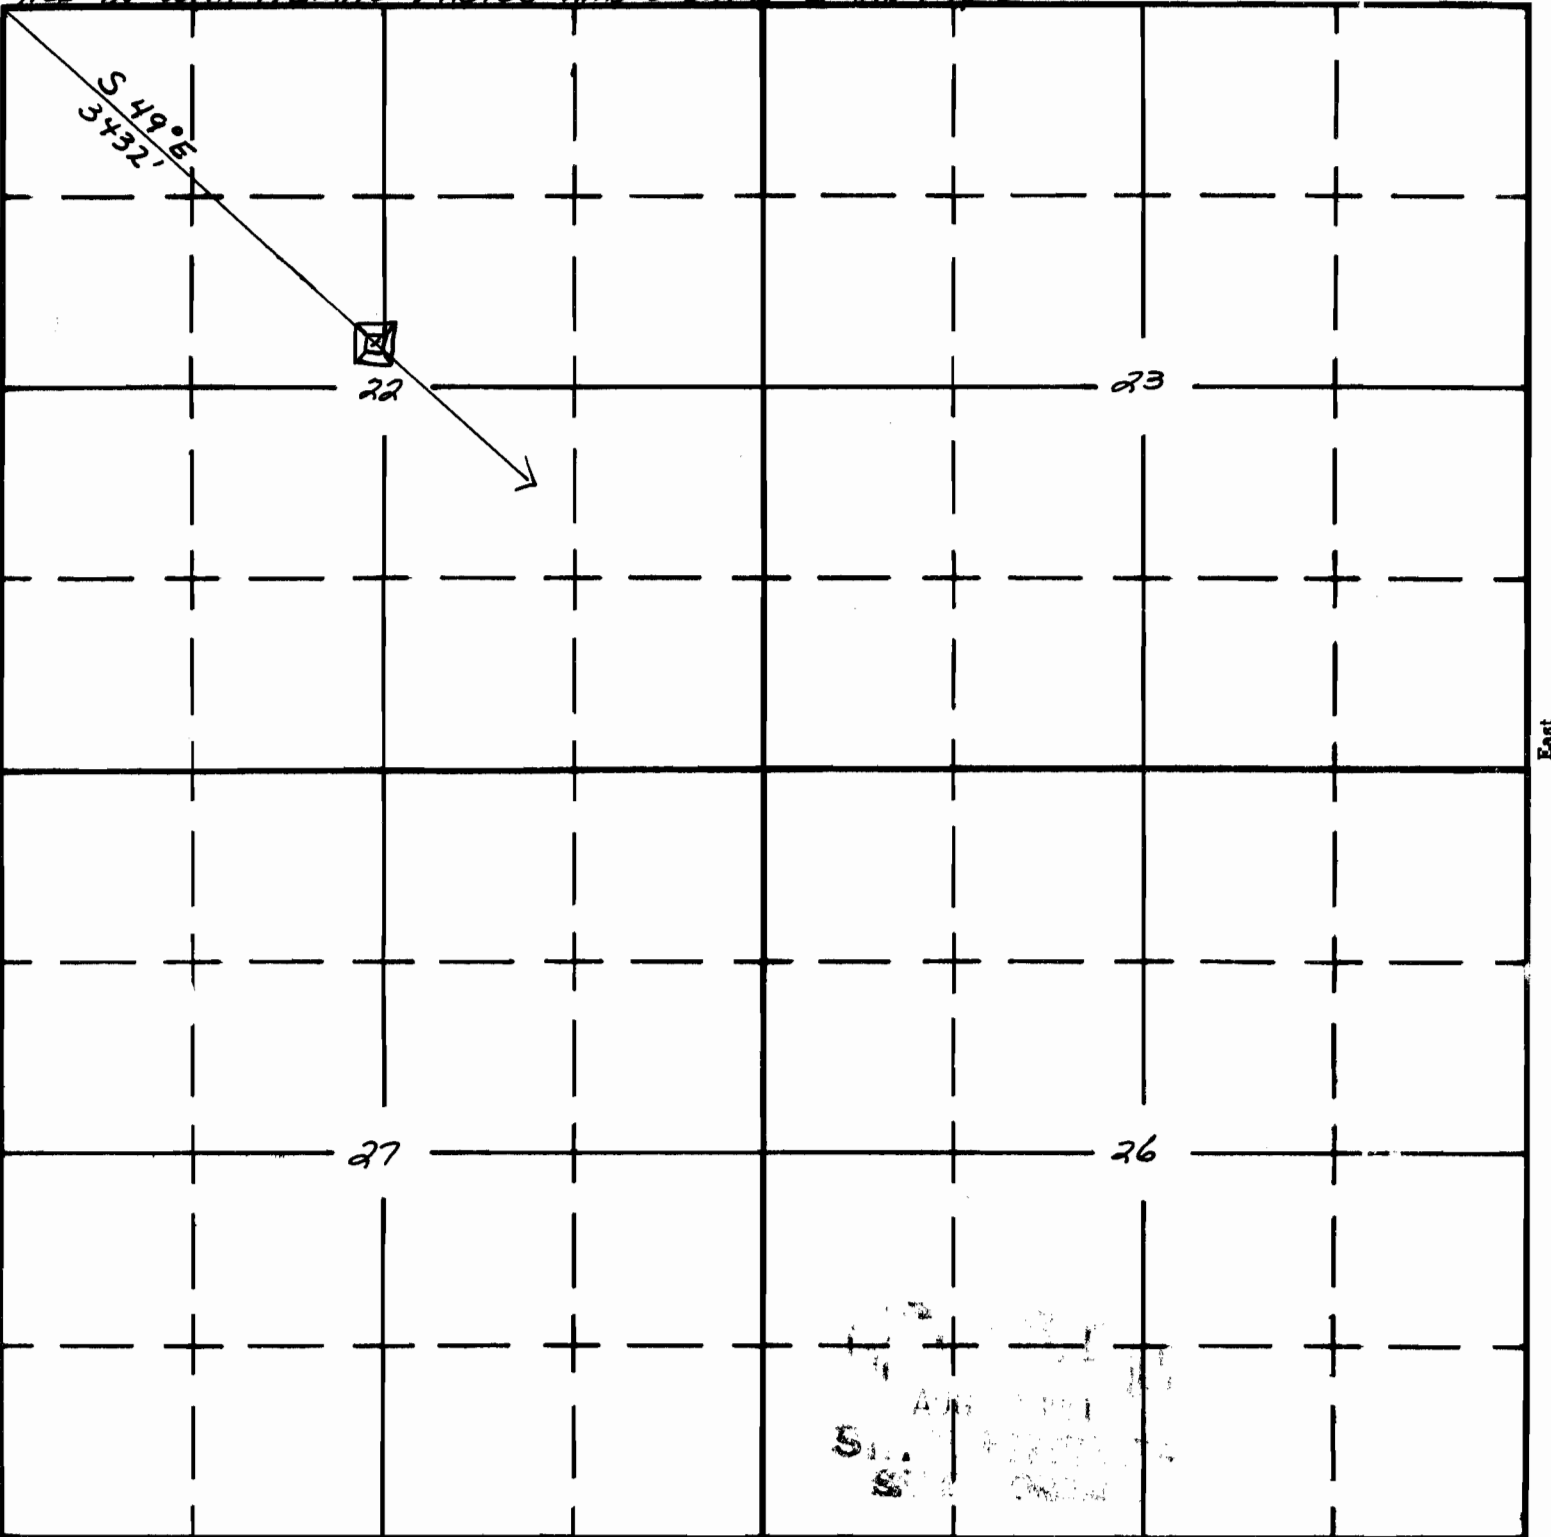

South

APPLICATION No. R-35951
PERMIT No. R-3729