

UNITED STATES
DEPARTMENT OF THE INTERIOR
BUREAU OF LAND MANAGEMENT


SECTION
31

Oregon State Water Filings

NE 1/4 SE 1/4

TOWNSHIP 36 S, RANGE 30 E, W. M.

Tied in with aerial photos: O.S.H.D. Quad Maps

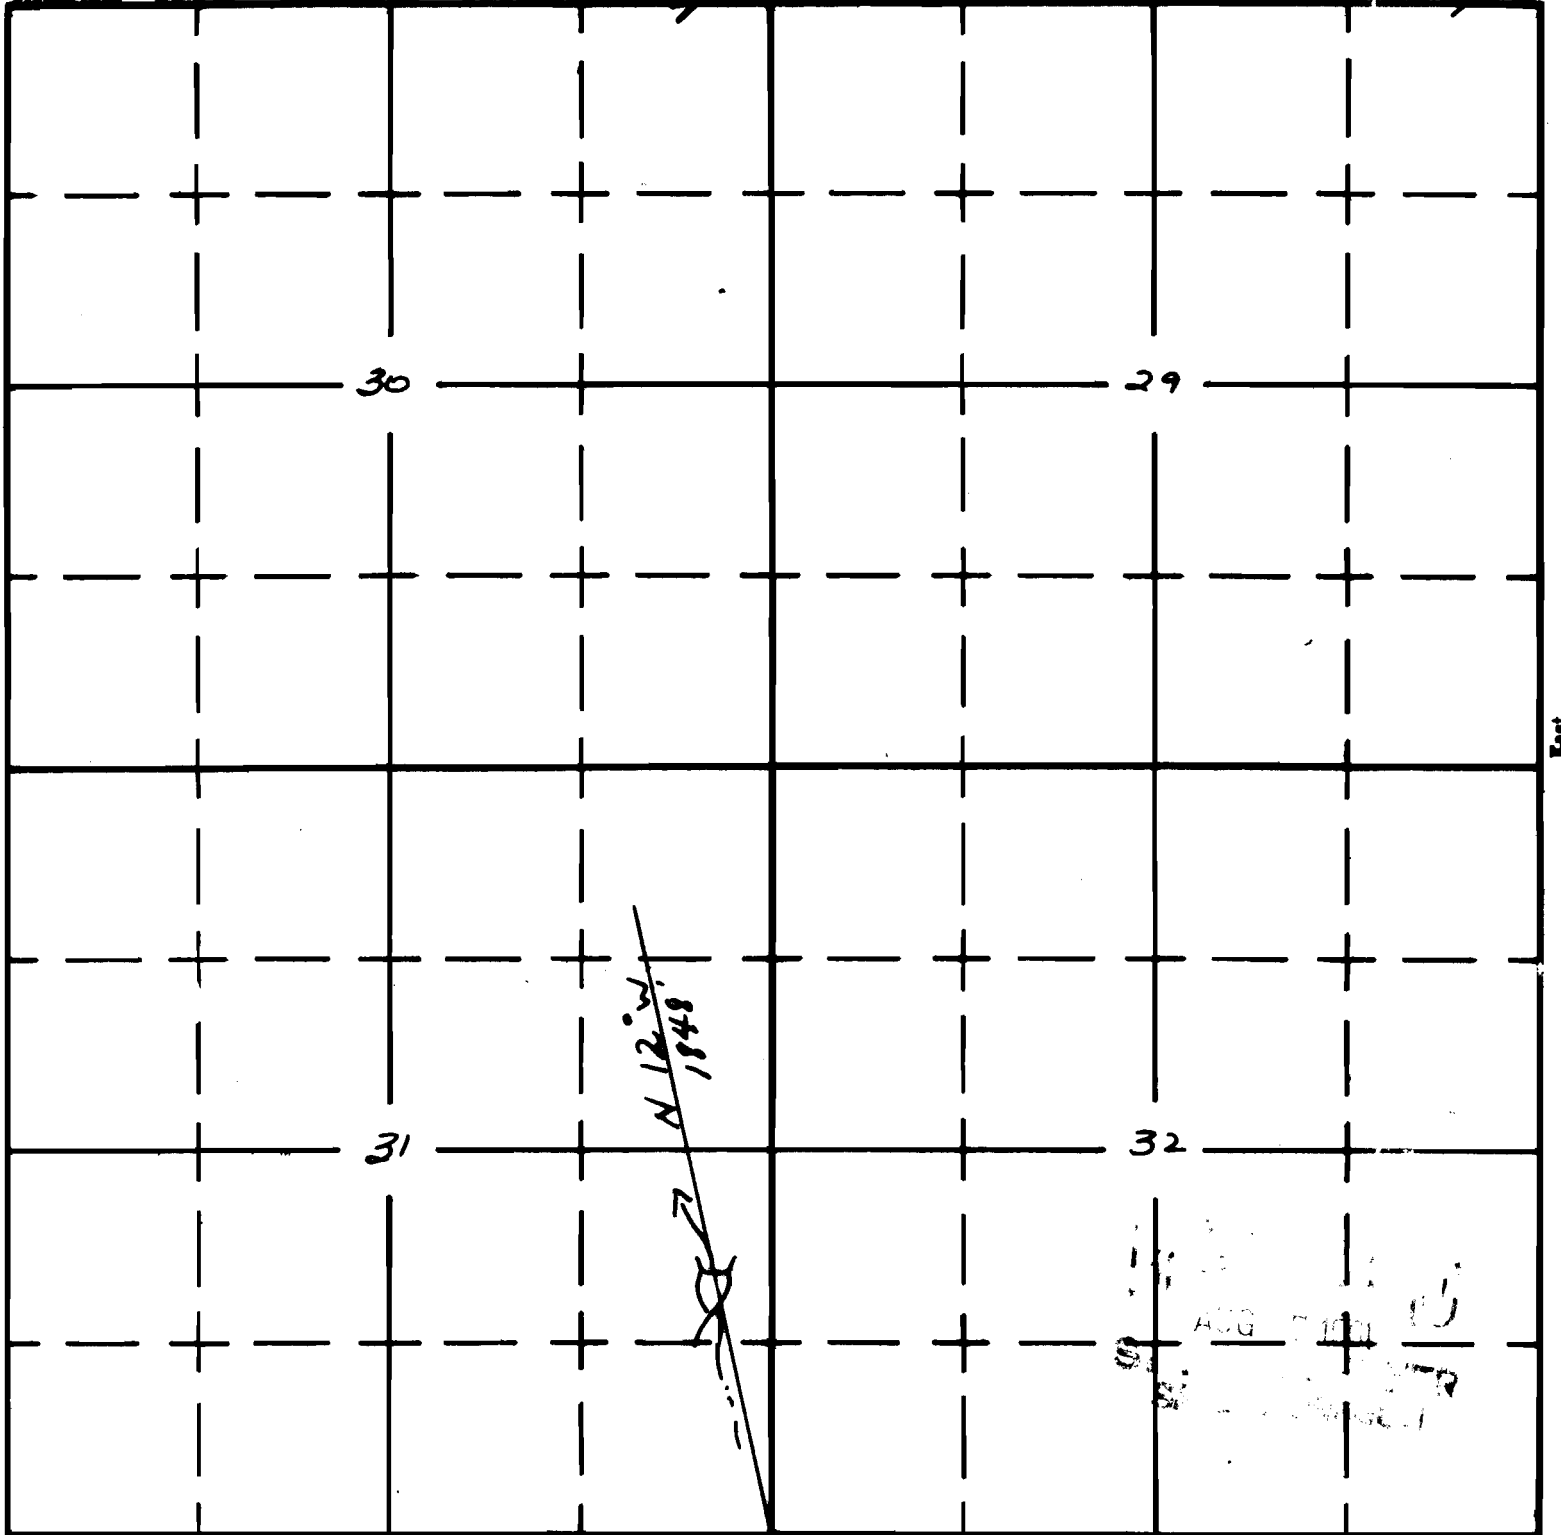

South

APPLICATION No. R-36289
PERMIT No. R-3782