Form A1-187
March 1961


UNITED STATES
DEPARTMENT OF THE INTERIOR
BUREAU OF LAND MANAGEMENT

SECTION 19


TOWNSHIP 38 S, RANGE 45 E, W. M.

Location Waterhole

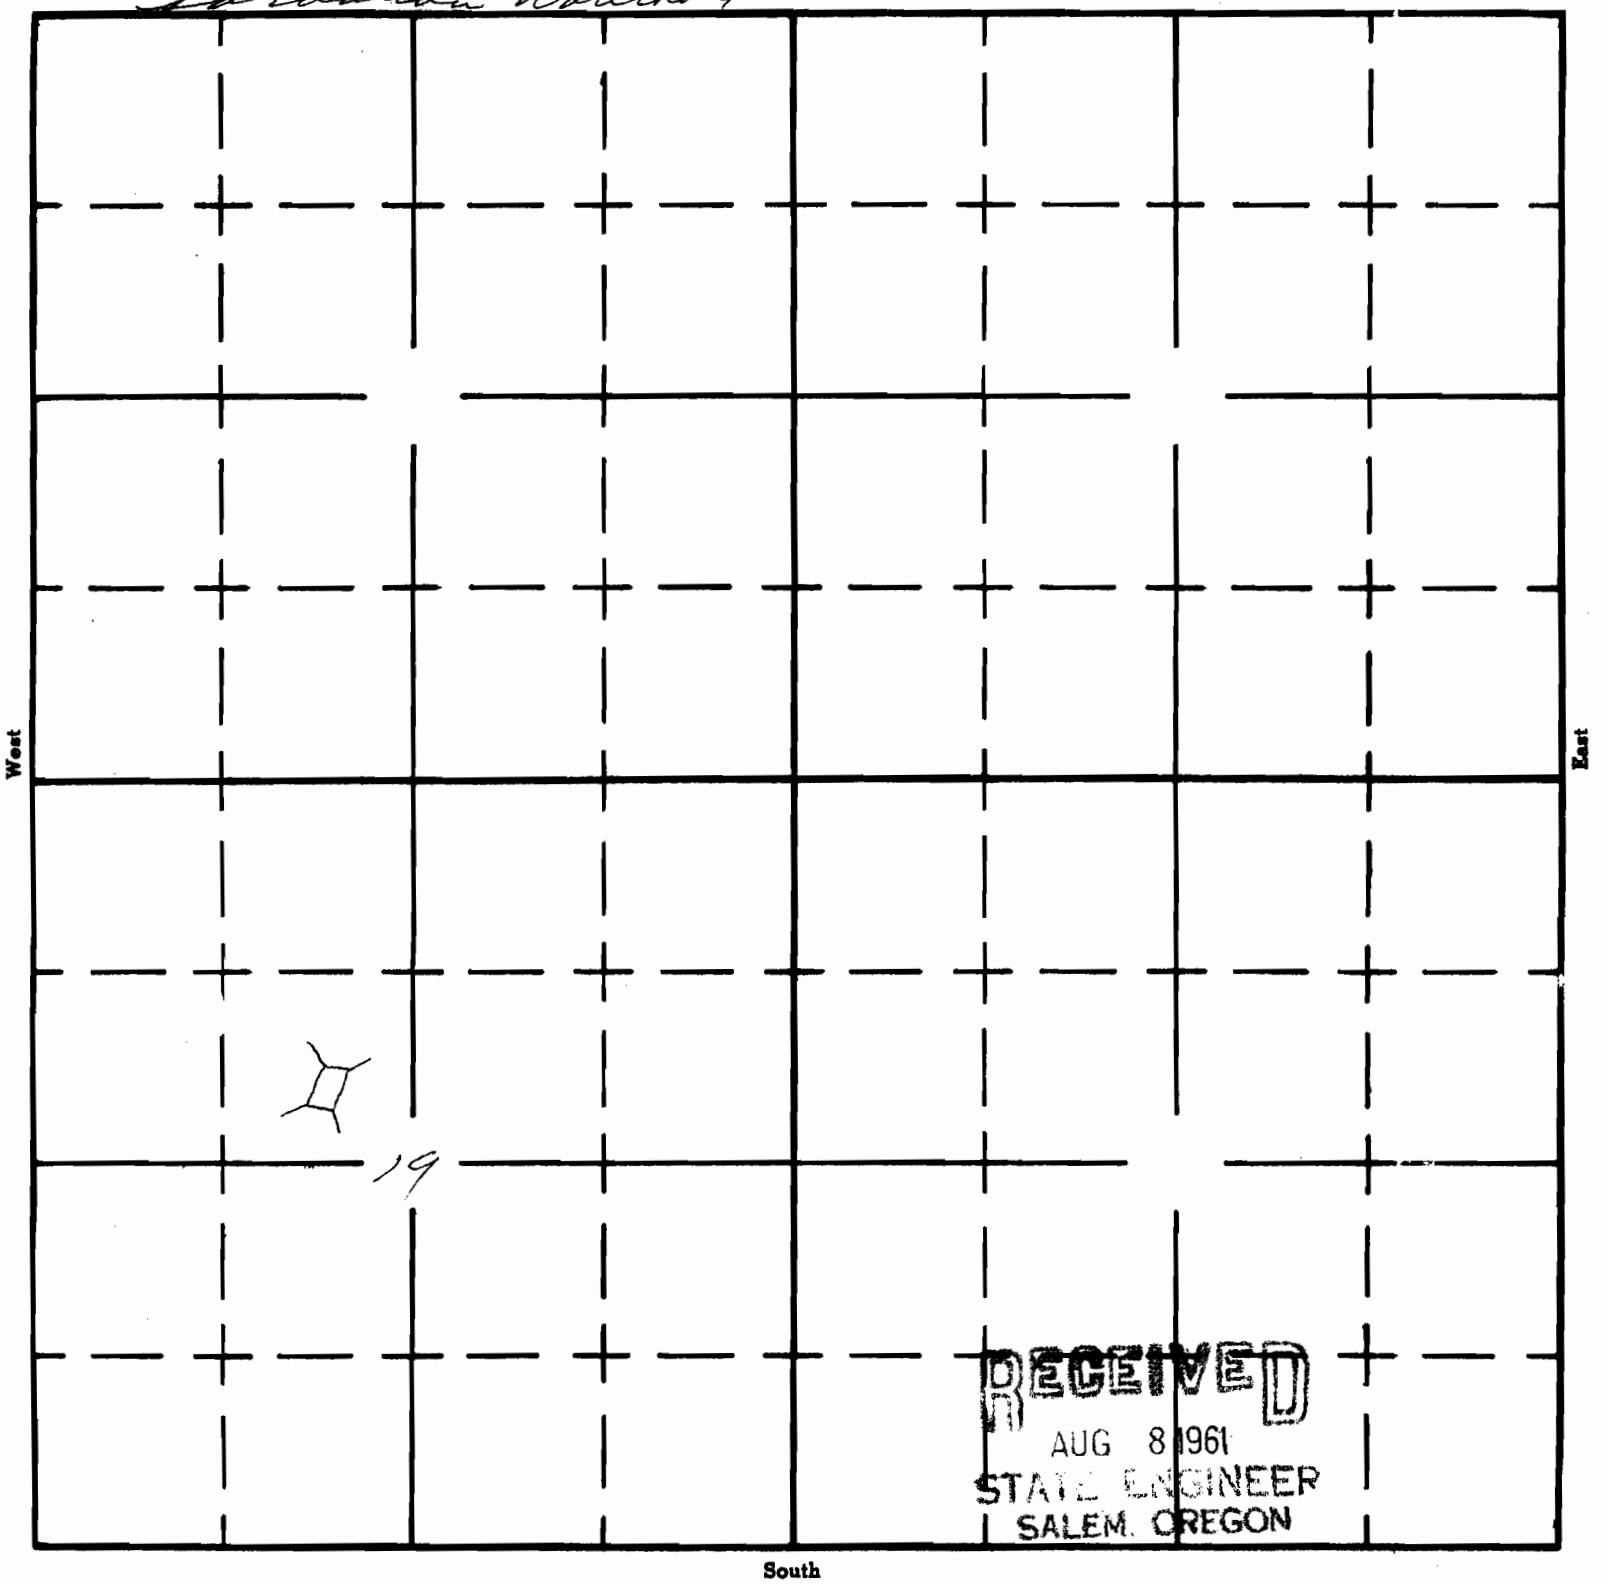


RECEIVED
AUG 8 1961
STATE ENGINEER
SALEM, OREGON

APPLICATION No. R-36698
PERMIT No. R-3818