

Form A1-187
March 1961


UNITED STATES
DEPARTMENT OF THE INTERIOR
BUREAU OF LAND MANAGEMENT

SECTION

Oregon State Water Filings

21
X

TOWNSHIP 22S, RANGE 43E, W. M.

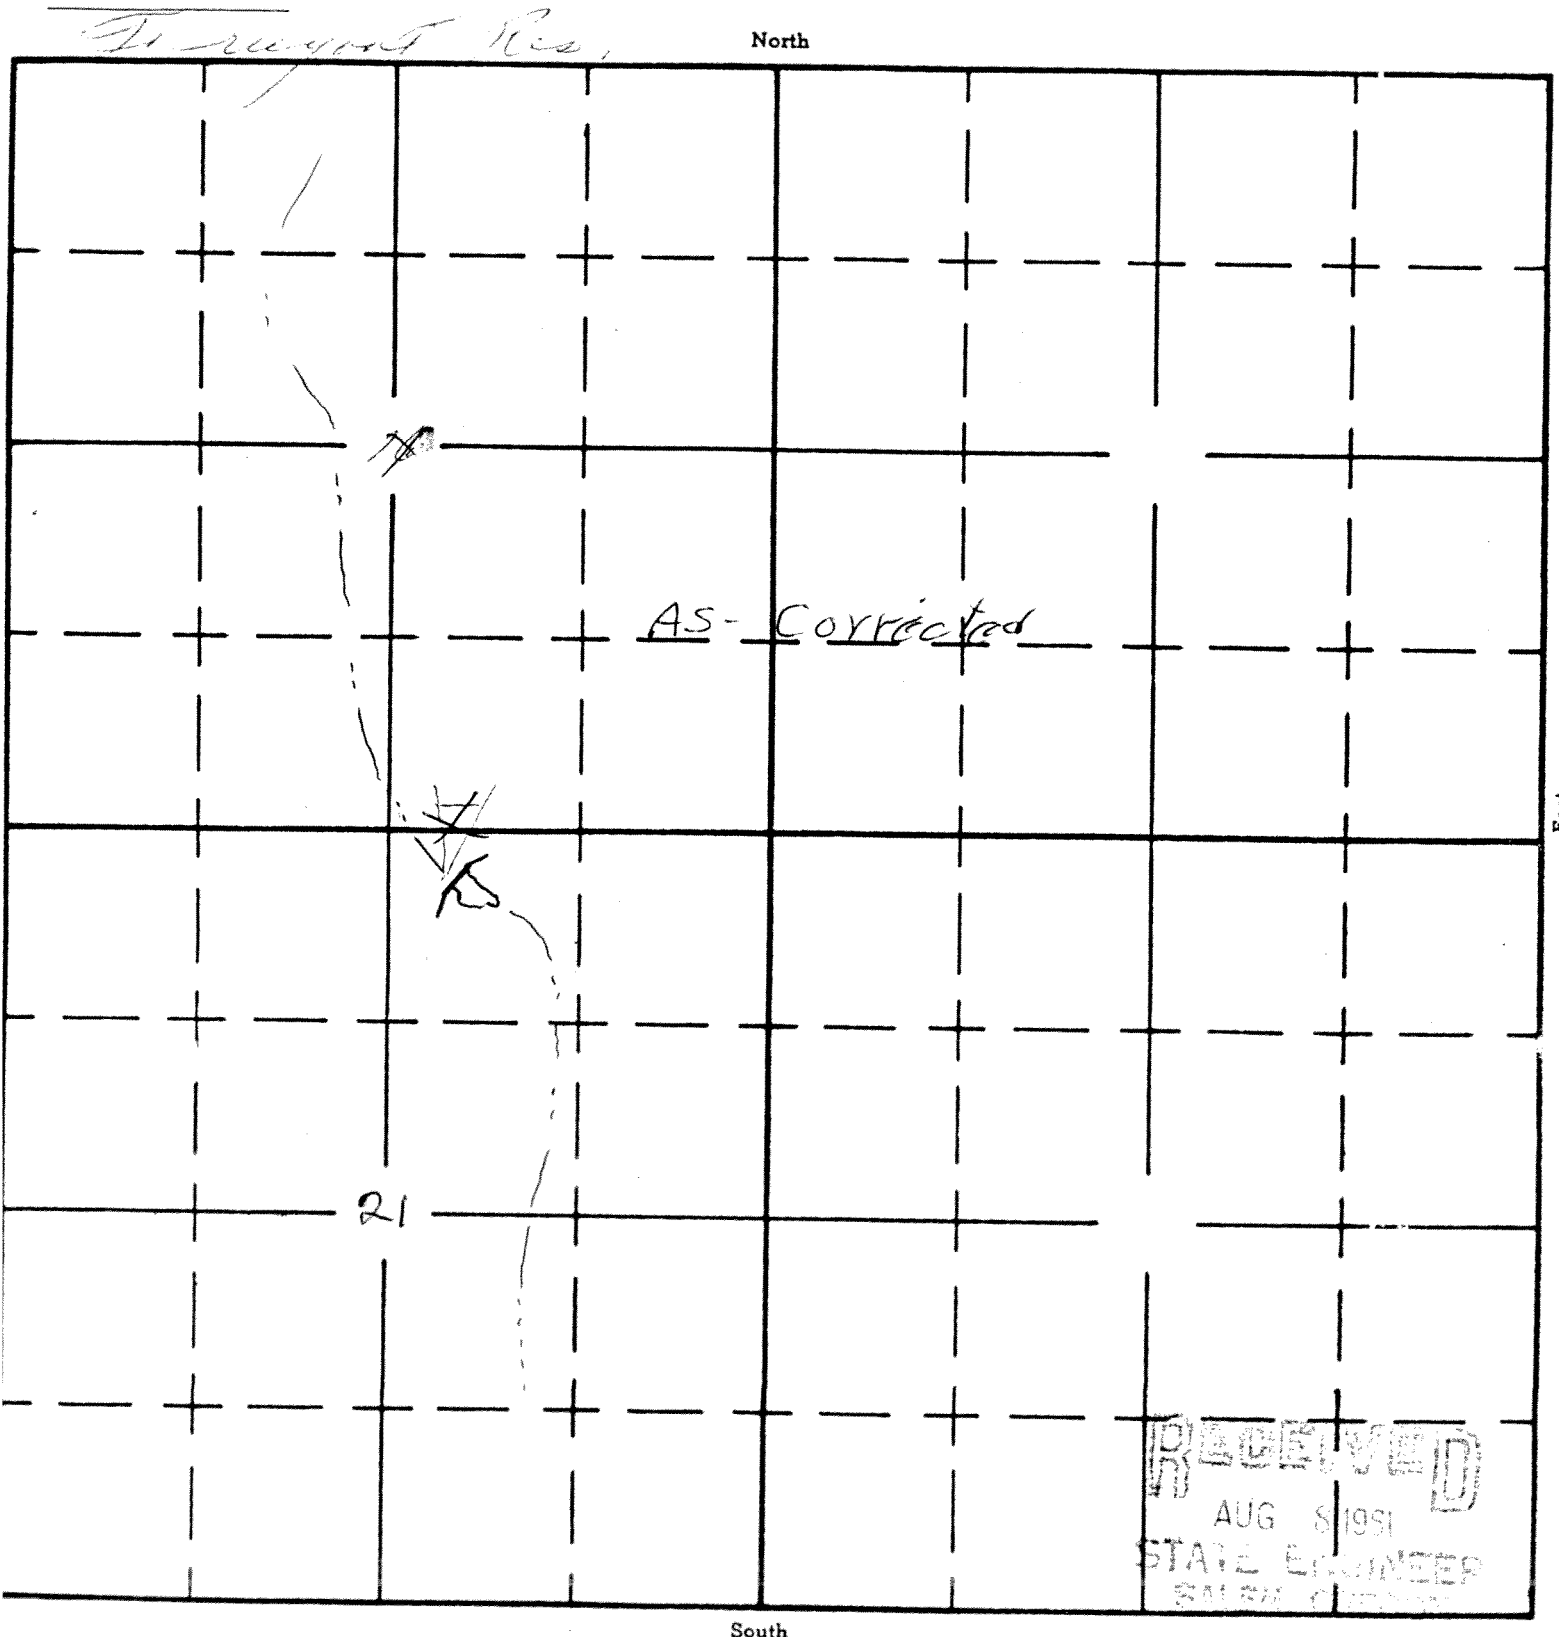

APPLICATION No. R-36866