

Form A1-187
March 1961

UNITED STATES
DEPARTMENT OF THE INTERIOR
BUREAU OF LAND MANAGEMENT

SECTION


NW 1/4 SE 1/4

SEC 19

Oregon State Water Filings

TOWNSHIP 28S, RANGE 27E, W. M.

North

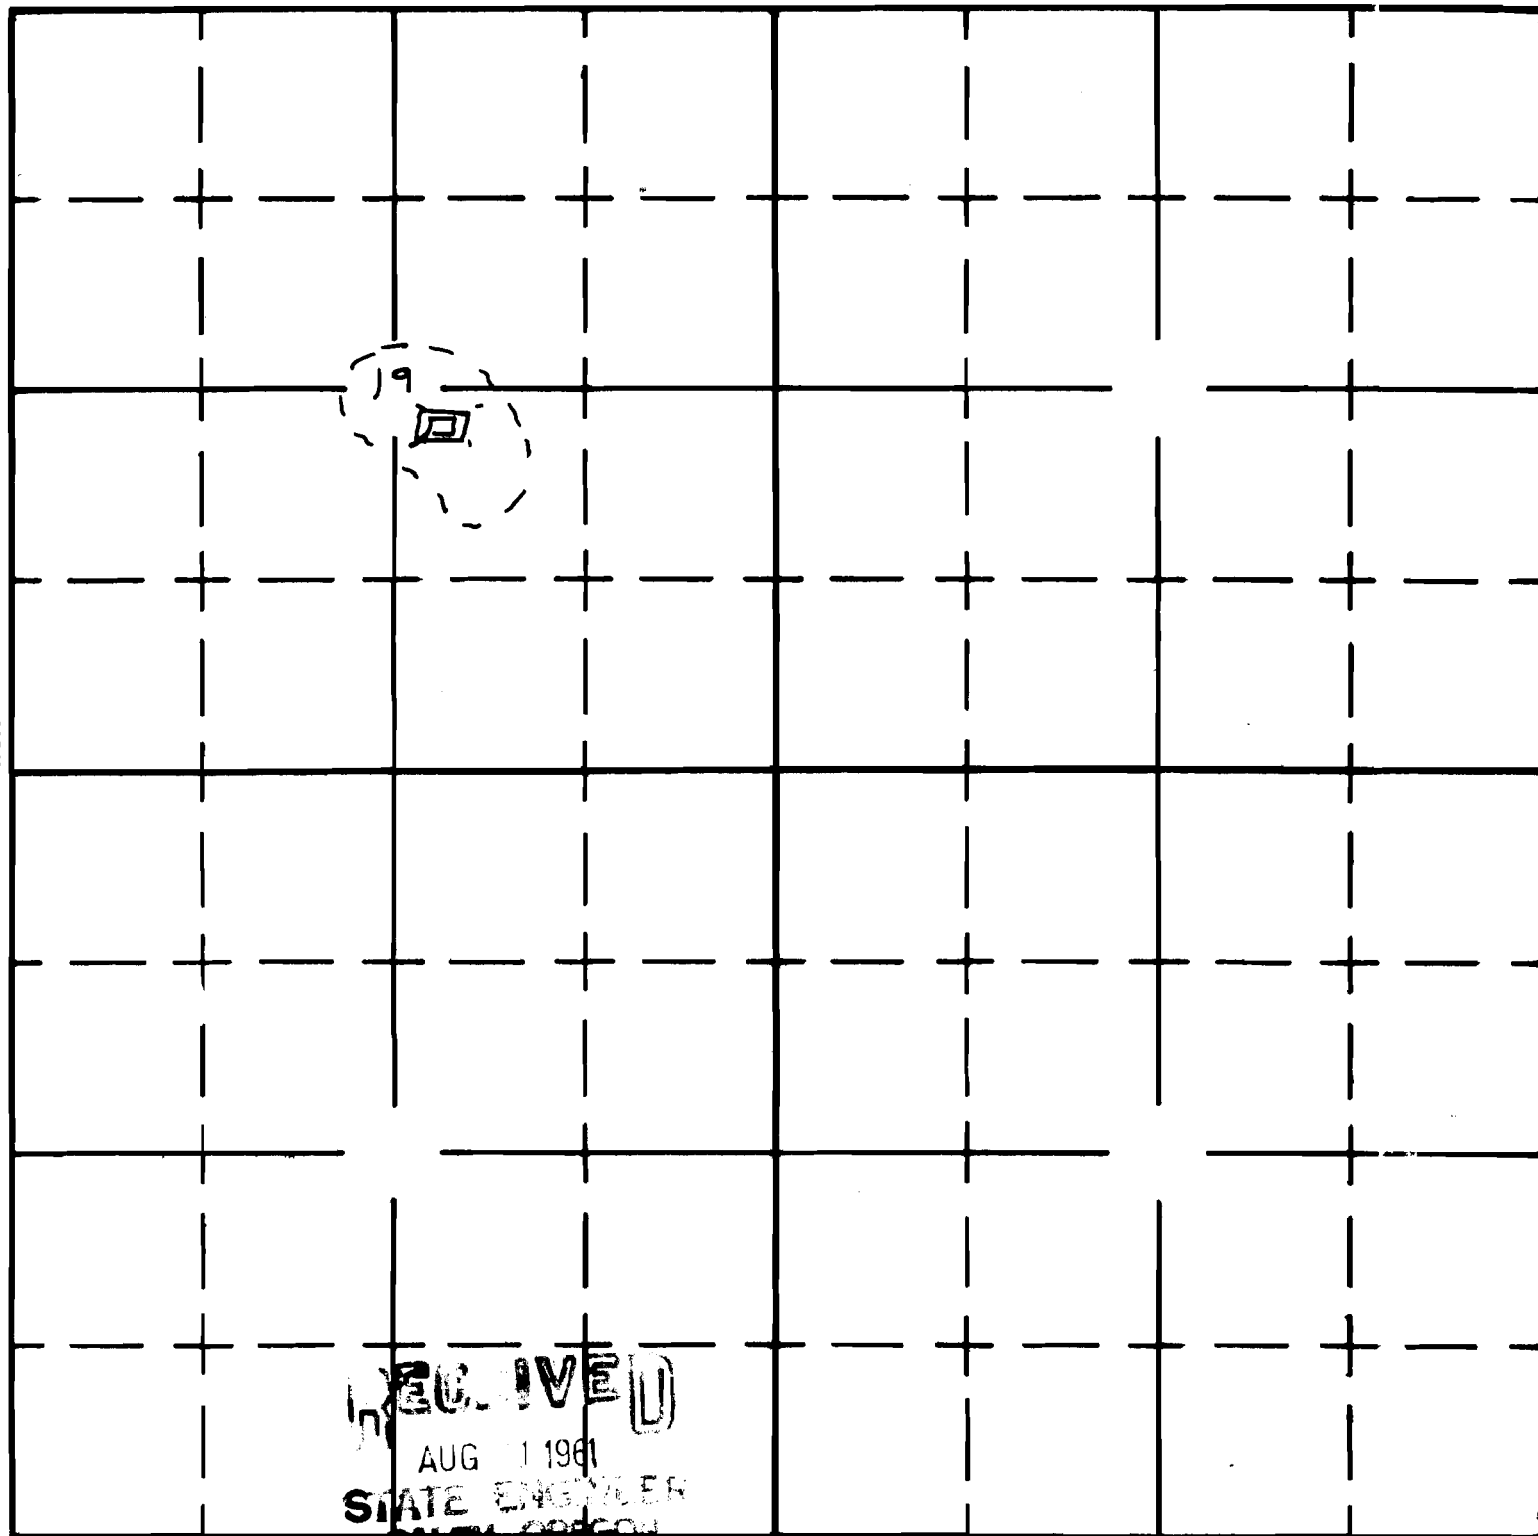

South

APPLICATION No. R-35886

PERMIT No. R-3918