


T. 38S., R. 2E., W.M.

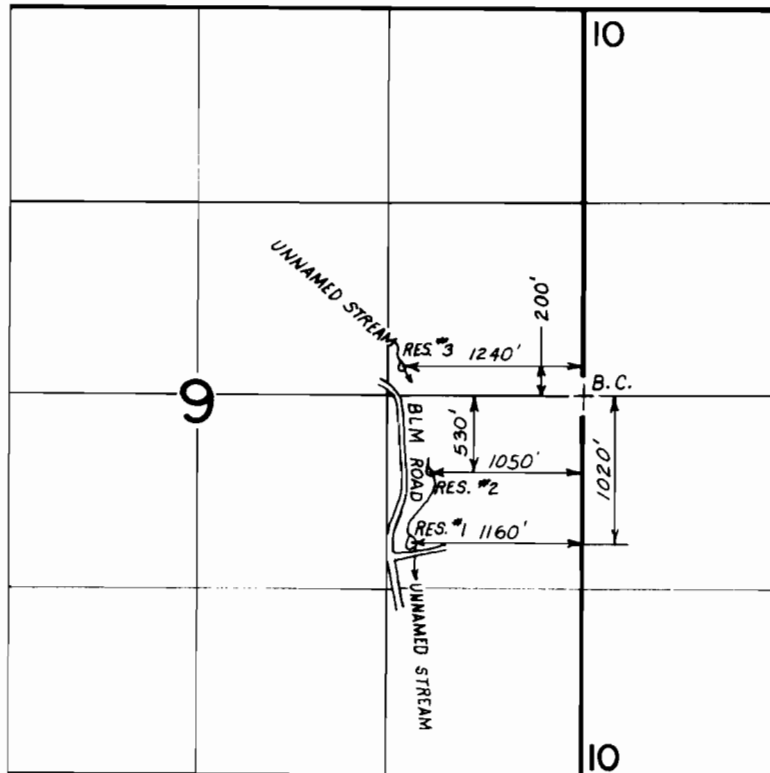

SCALE: 1" = 1320'

FINAL PROOF SURVEY

UNDER

R-34244 R-3985-#1
R-34245 R-3986-#2
Application No. R-34246 Permit No. R-3987-#3

IN NAME OF

..... BUREAU of LAND MANAGEMENT

Surveyed JUNE 22 1984, by B. SUZIE JAMES