

Form A1-187
March 1961

UNITED STATES
DEPARTMENT OF THE INTERIOR
BUREAU OF LAND MANAGEMENT


SECTION

NW NE Sec. 34

Oregon State Water Filings

TOWNSHIP 38S, RANGE 26E, W. M.

North

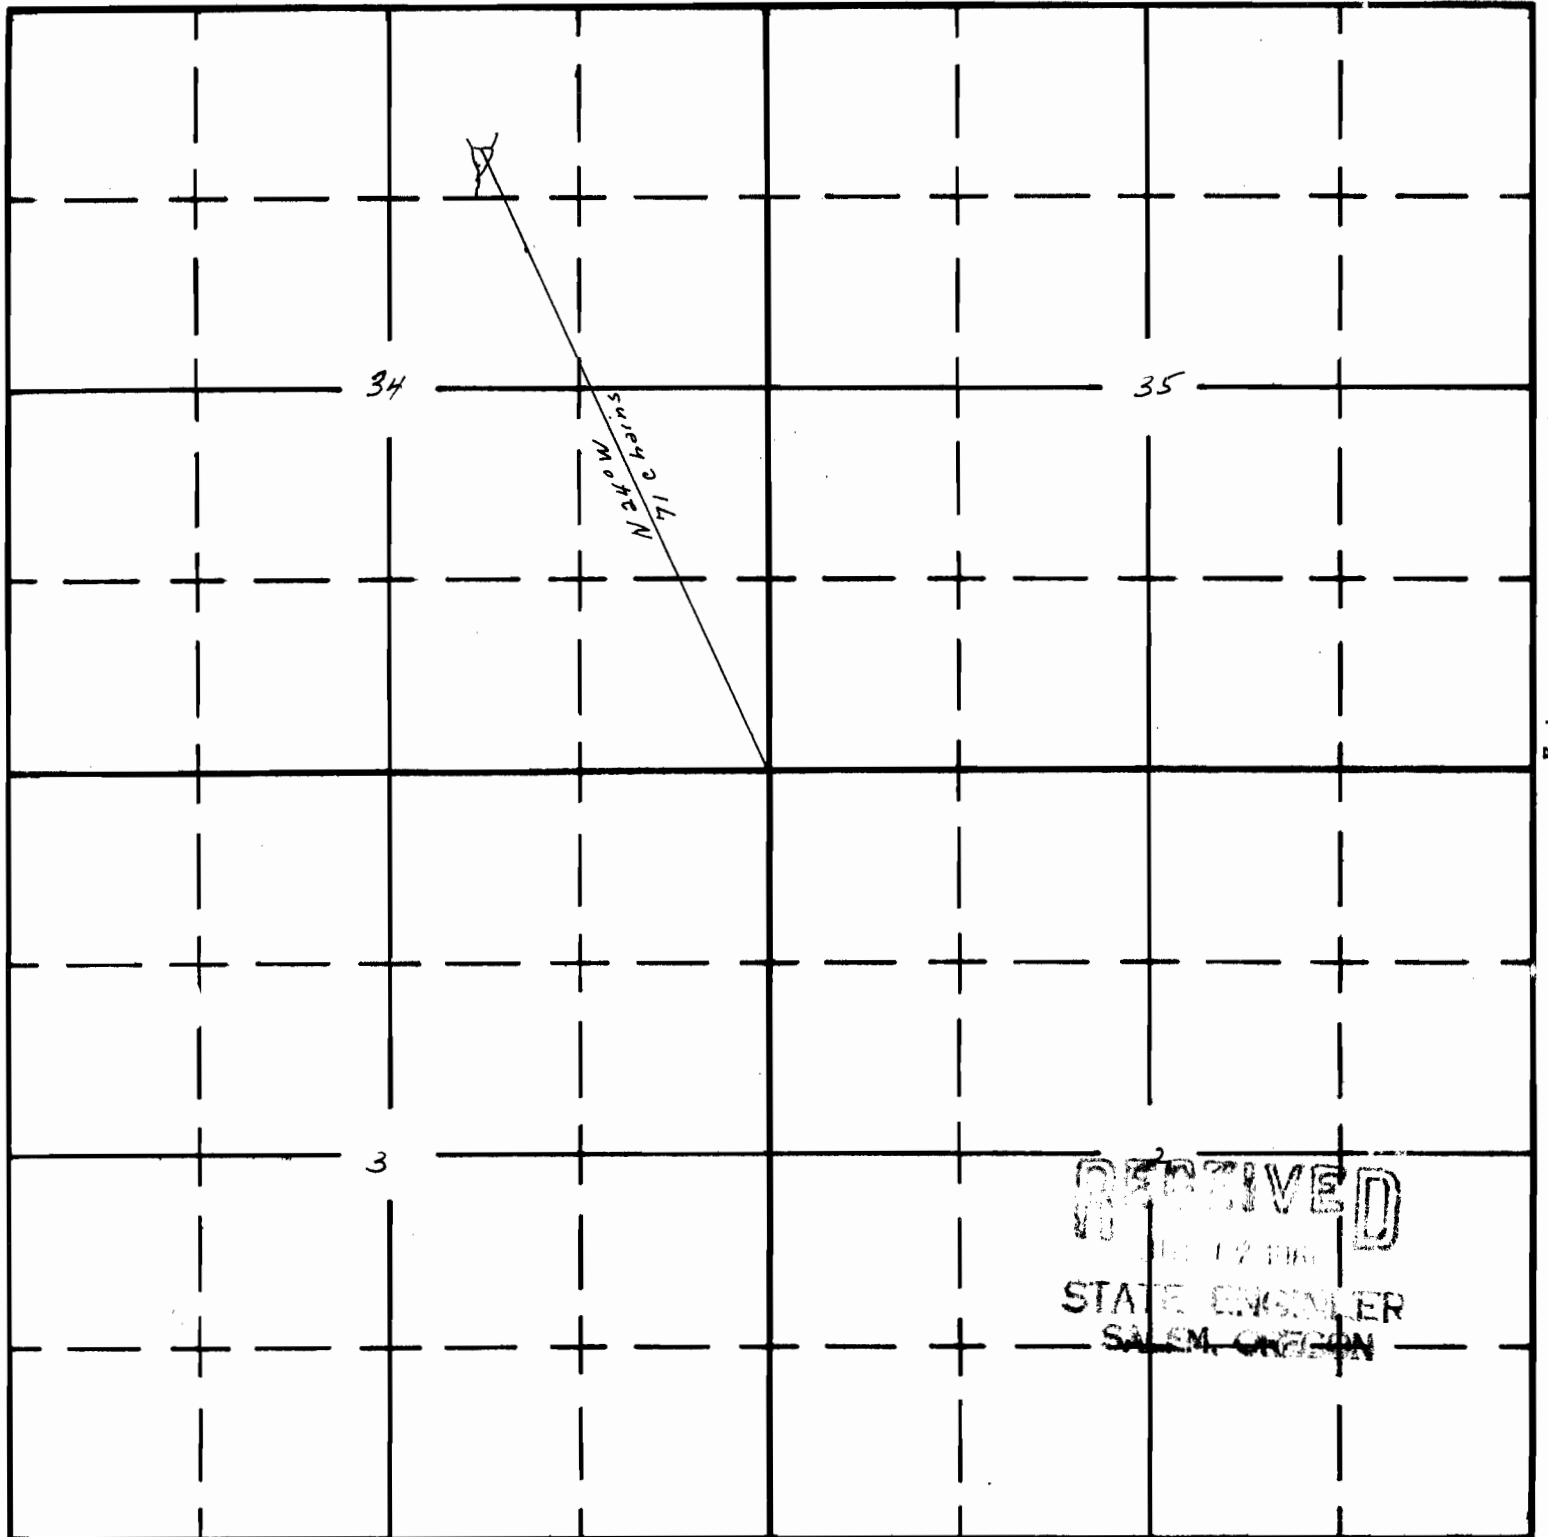

South

RECEIVED
JUL 12 1961
STATE ENGINEER
SALEM, OREGON

APPLICATION No. **R-35162**

PERMIT No. **8-8998**