

Form AI-187
March 1961

UNITED STATES
DEPARTMENT OF THE INTERIOR
BUREAU OF LAND MANAGEMENT


SECTION

NW NE Sec. 14

Oregon State Water Filings

TOWNSHIP 41S, RANGE 25E, W. M.

North

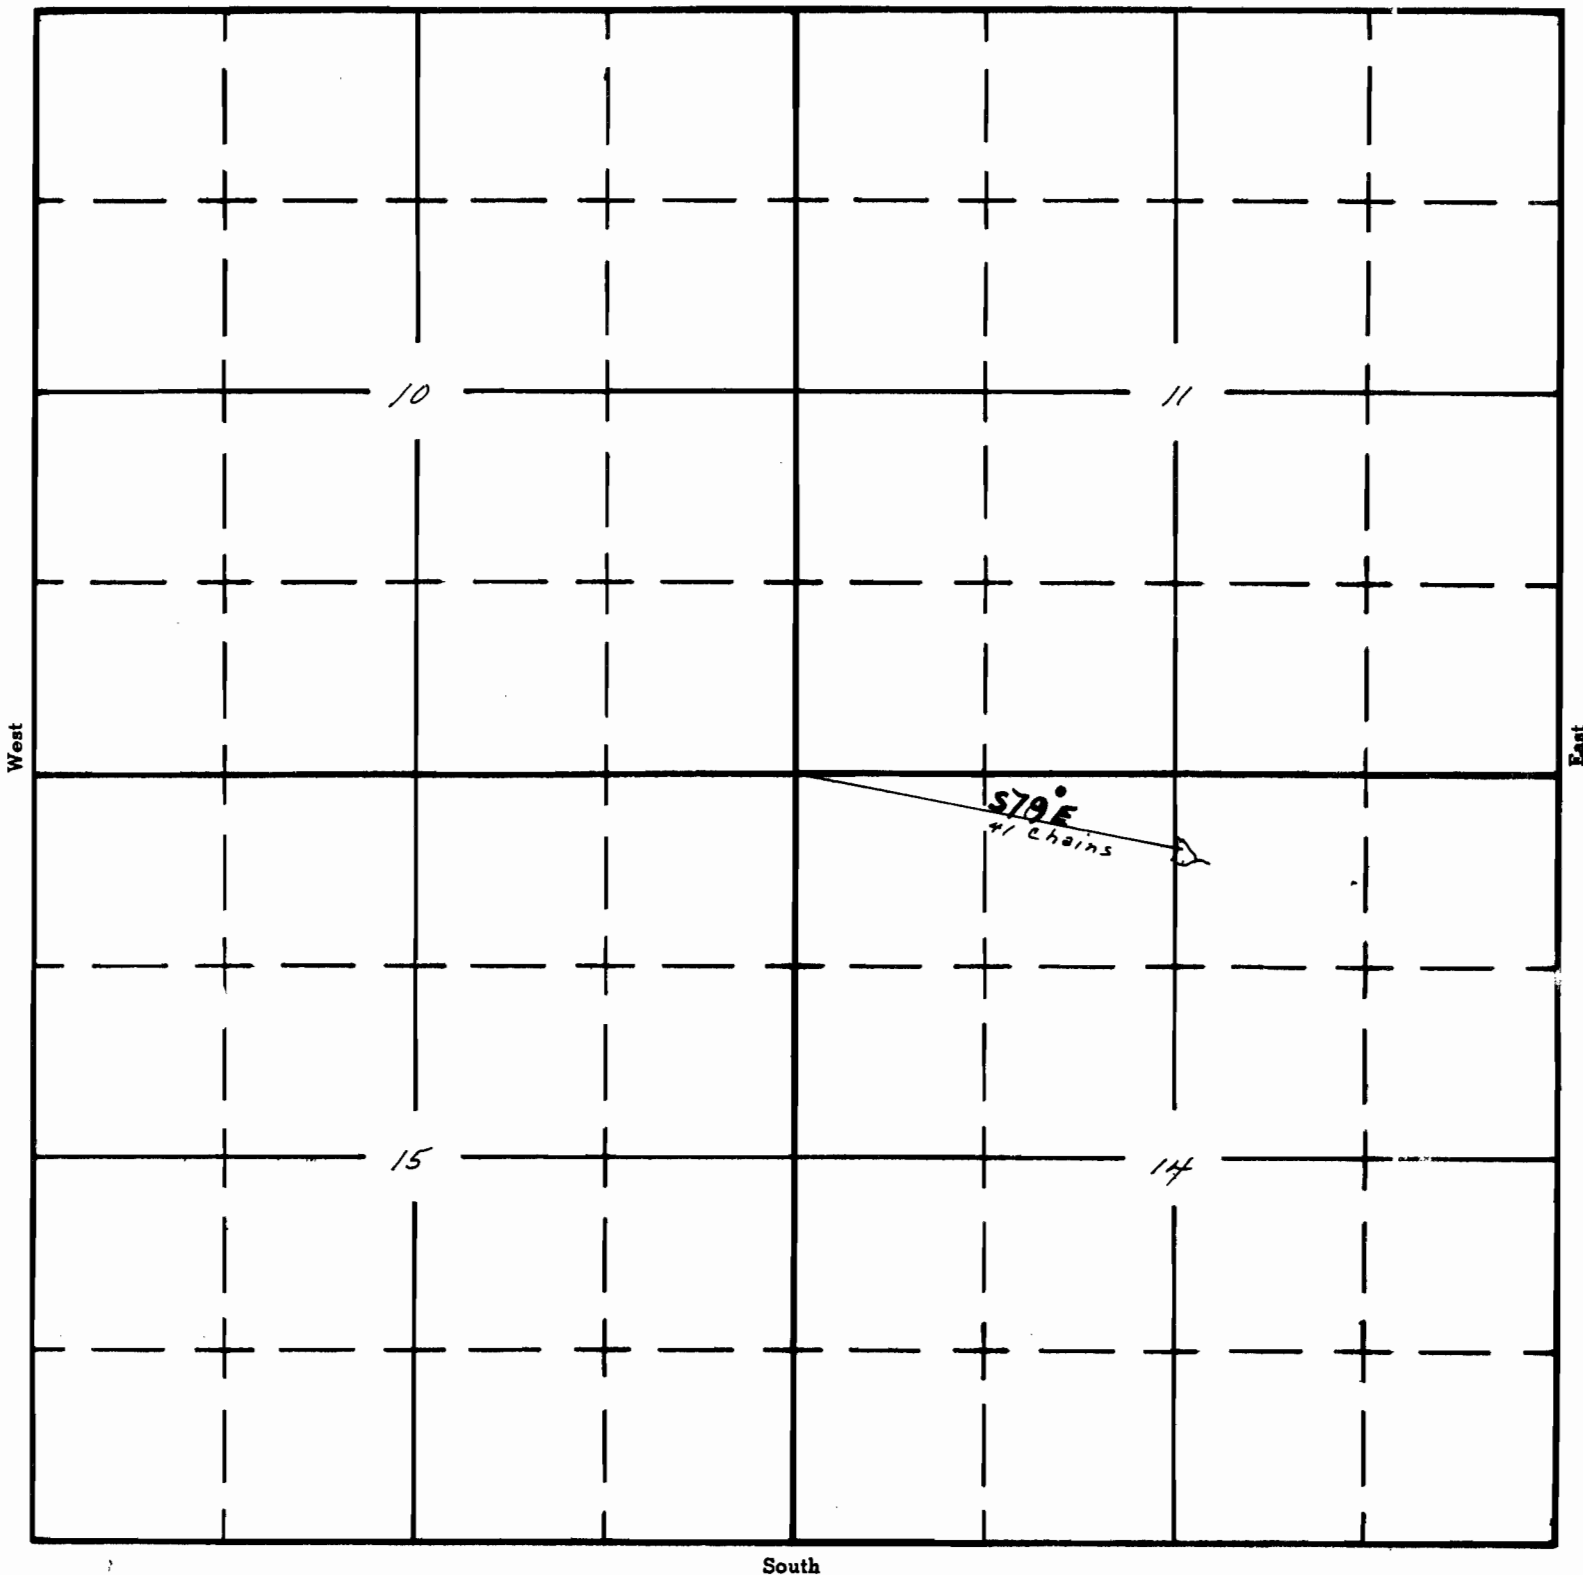

South

APPLICATION No. R-35199
PERMIT No. R-4000