


Form AI-187
March 1961

UNITED STATES
DEPARTMENT OF THE INTERIOR
BUREAU OF LAND MANAGEMENT

SECTION SW 1/4 SE 1/4 Oregon State Water Filings

31 TOWNSHIP 24S, RANGE 24E, W. M.

North

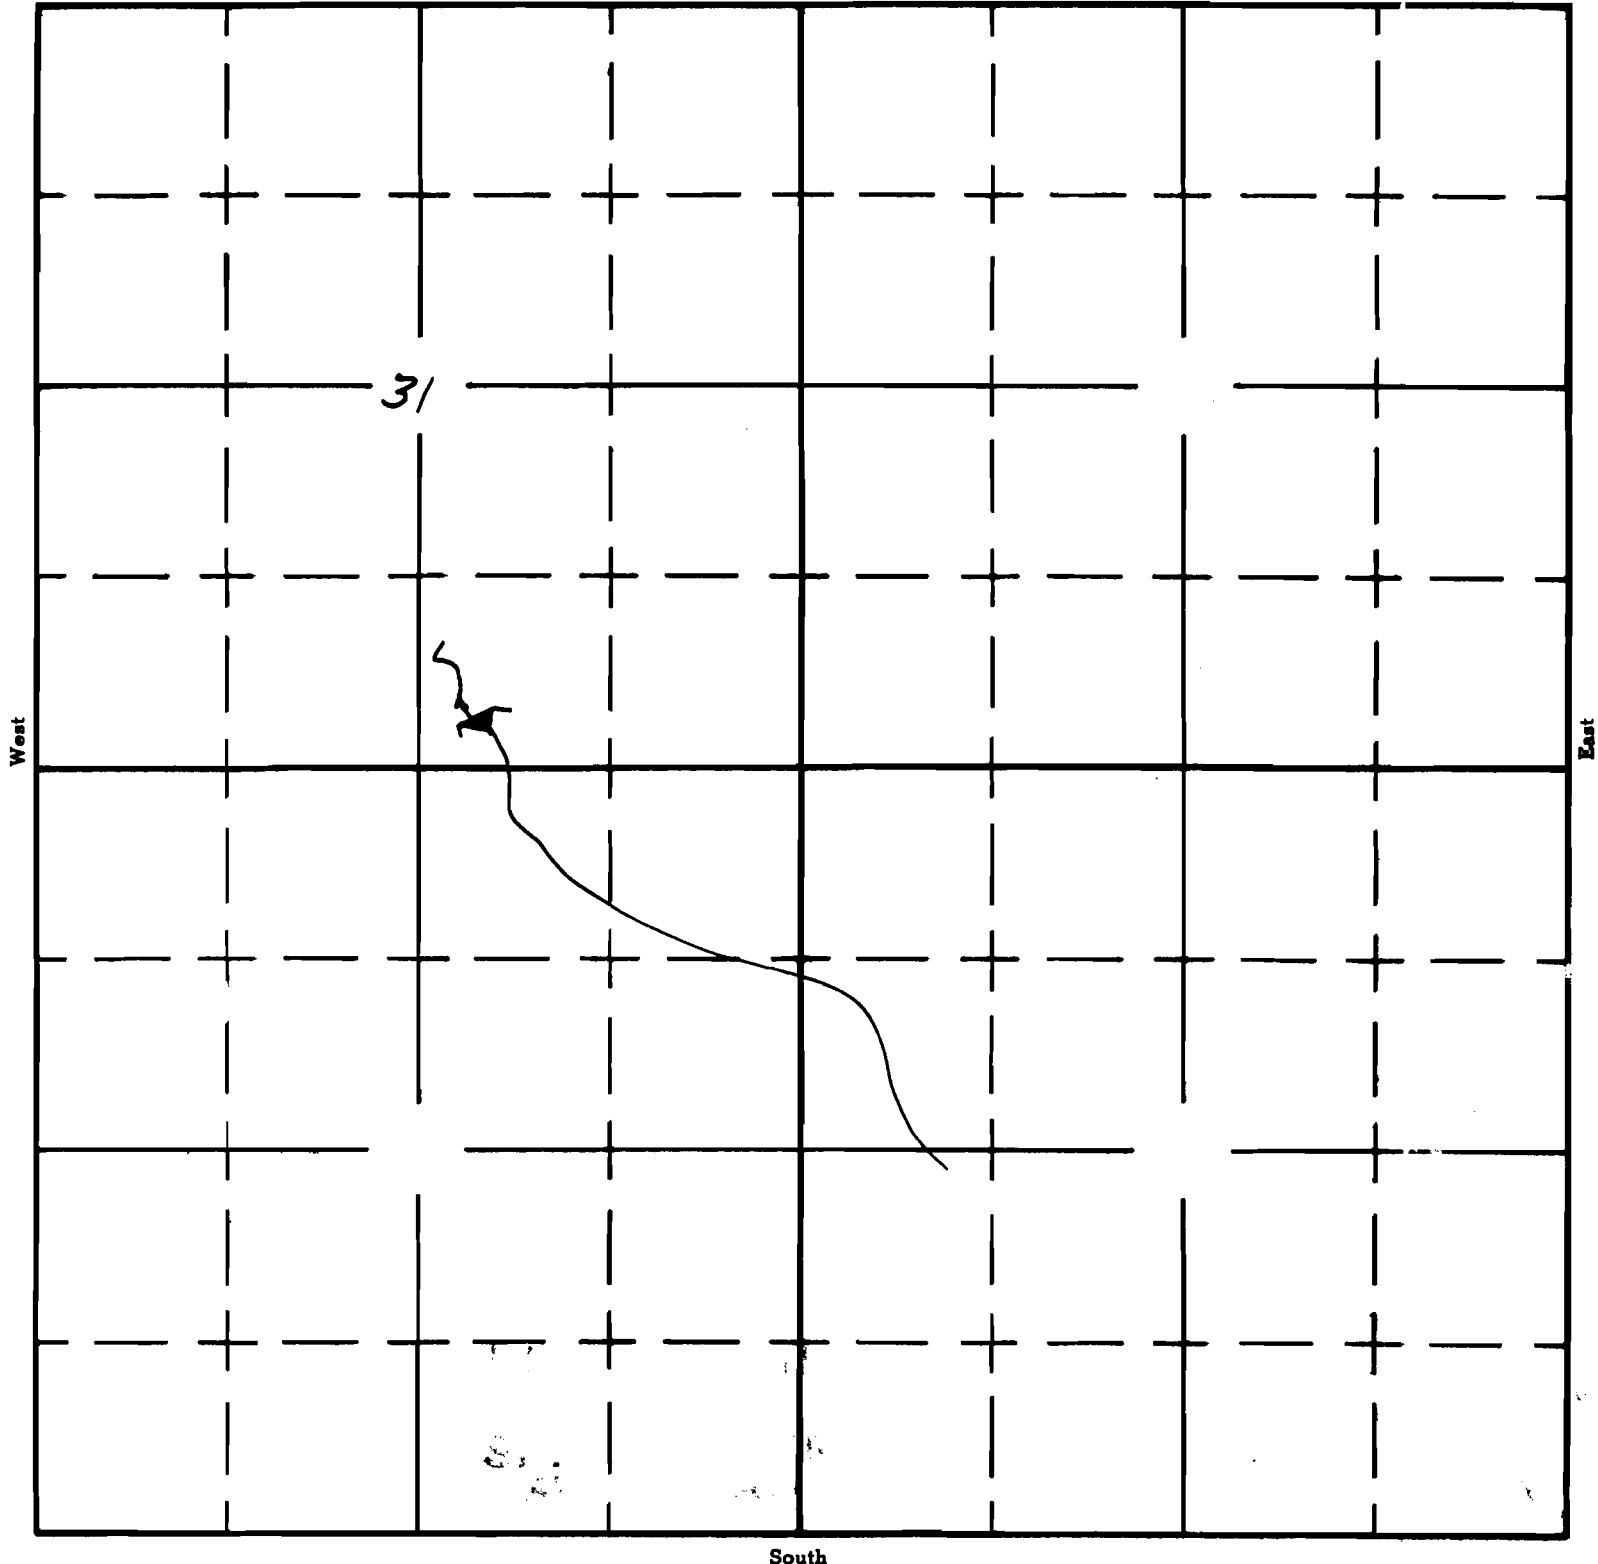

South

APPLICATION No. R-35629
PERMIT No. R-4021